


T.23S. R. 7W.W.M.

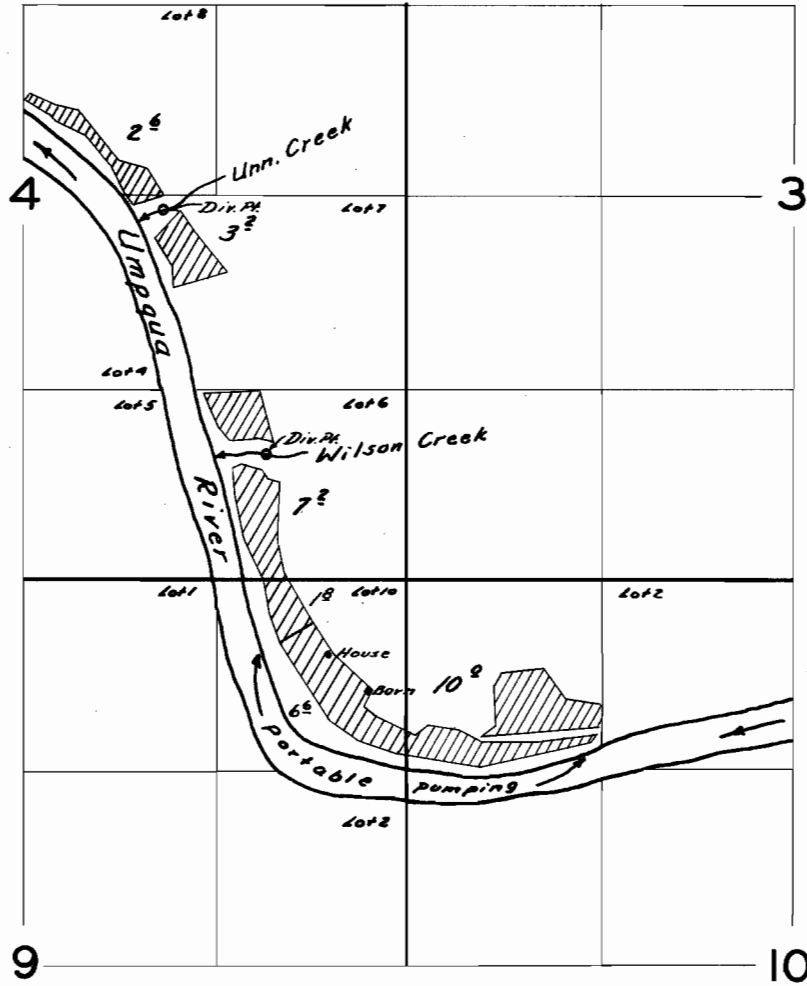

**FINAL PROOF SURVEY**

UNDER

Application No. 23367 Permit No. 18453

IN NAME OF

MRS. AGNES JONES

Surveyed June 22 1956, by C.O. Bartels