


T.22 S.R.4 W.W.M

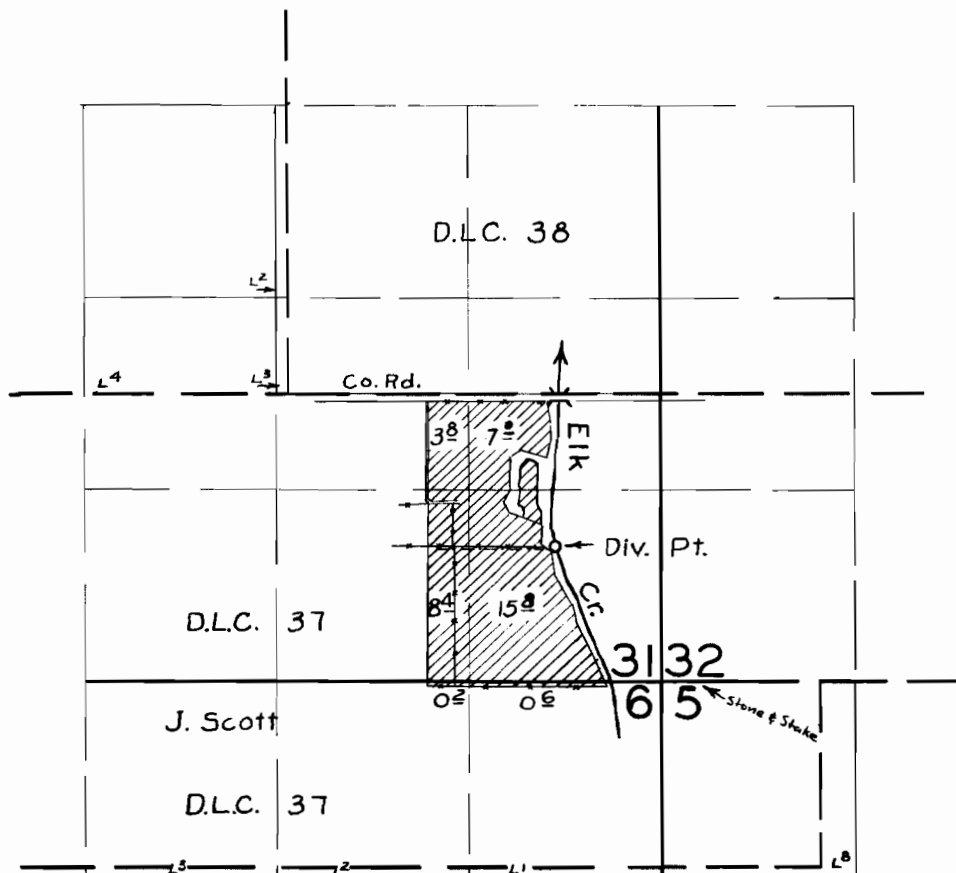

FINAL PROOF SURVEY UNDER

Application No. 24293 Permit No. 19122
IN NAME OF

Fred Booth & Dan R. Russell

Surveyed 12 Sept. 1957, by M. Bish

RECEIVED

JUN 18 2001

TRANSFER APPLICATION MAP IN THE NAME OF OREGON WATER TRUST



WATER RESOURCES DEPT.
SALEM, OREGON

PERMIT 19122

CERTIFICATE 46040


T-8844

SECTION 31, TOWNSHIP 22 SOUTH, RANGE 4 WEST, W.M.

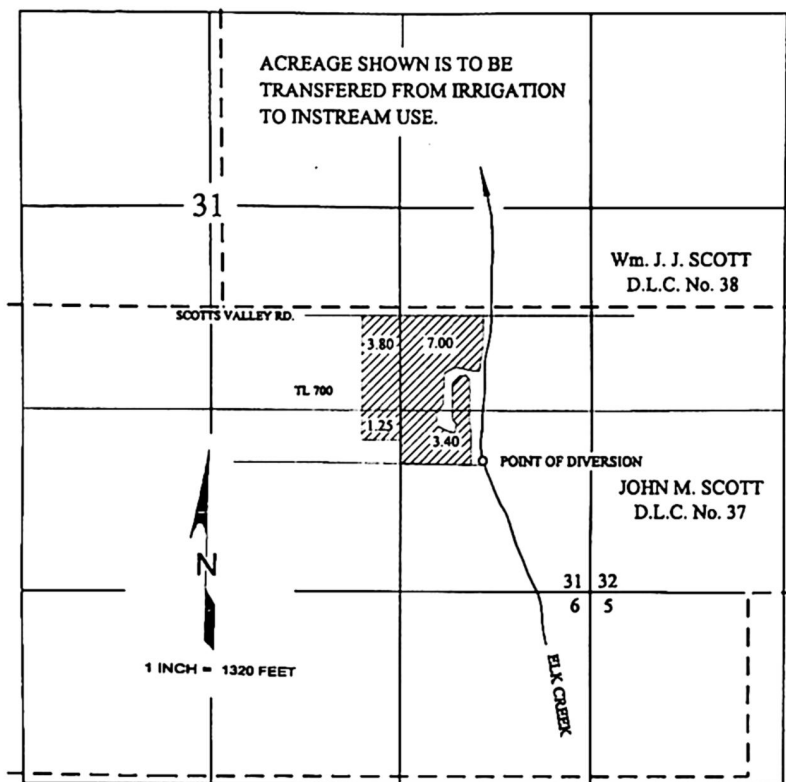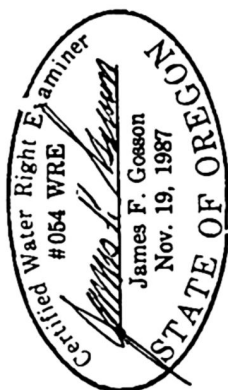

THE EXISTING POINT OF DIVERSION IS LOCATED 900 FEET NORTH AND 800 FEET WEST FROM THE SOUTHEAST CORNER OF SECTION 31, BEING WITHIN THE SE $\frac{1}{4}$ SE $\frac{1}{4}$ OF SECTION 31 AS PROJECTED WITHIN D.L.C. 27, TOWNSHIP 22 SOUTH, RANGE 4 WEST, W.M.; DOUGLAS COUNTY.

POTENTIAL AREA OF INSTREAM USE

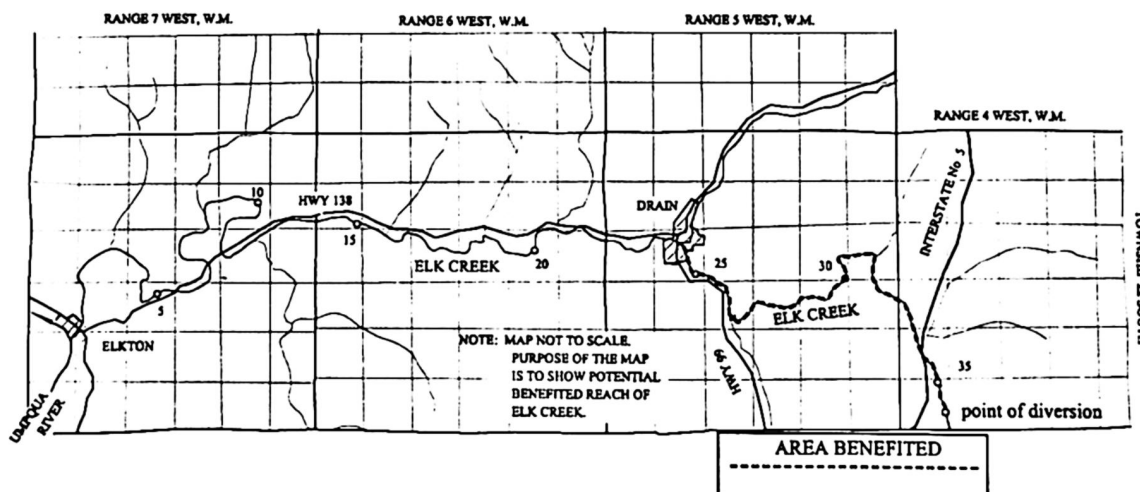

THE PURPOSE OF THIS MAP IS TO IDENTIFY THE LOCATION OF THE WATER RIGHT. IT IS NOT INTENDED TO PROVIDE INFORMATION RELATIVE TO THE LOCATION OF PROPERTY OWNERSHIP BOUNDARY LINES.