


34999

46042

T.13S., R.28E., W.M.

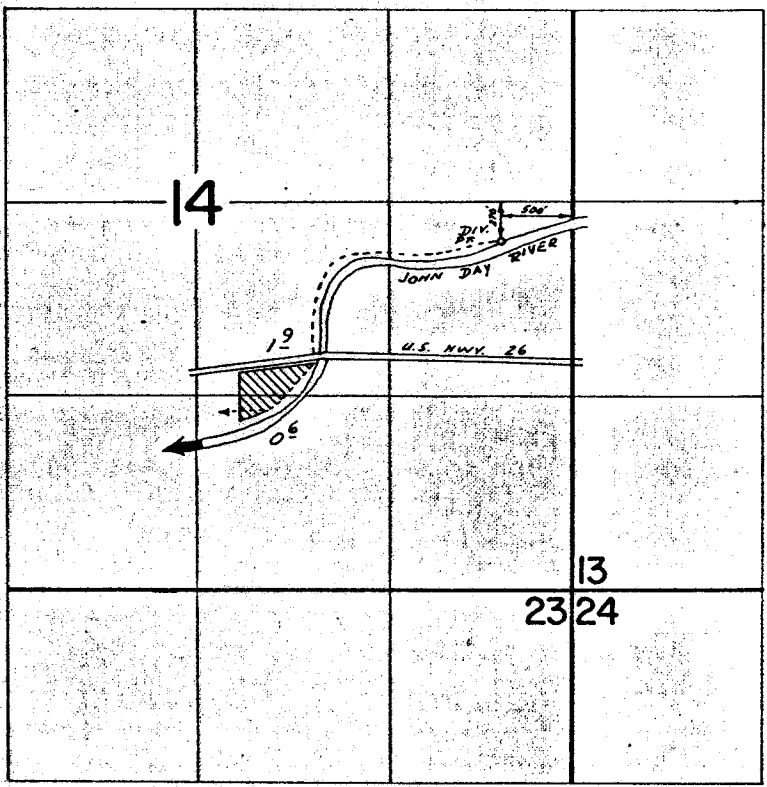

FINAL PROOF SURVEY
UNDER

Application No. 46799 Permit No. 34999
IN NAME OF

JOSEPH C. BERRY

Surveyed June 21 1975 by D. Norby