


T. 20S. R. 35E. W.M.

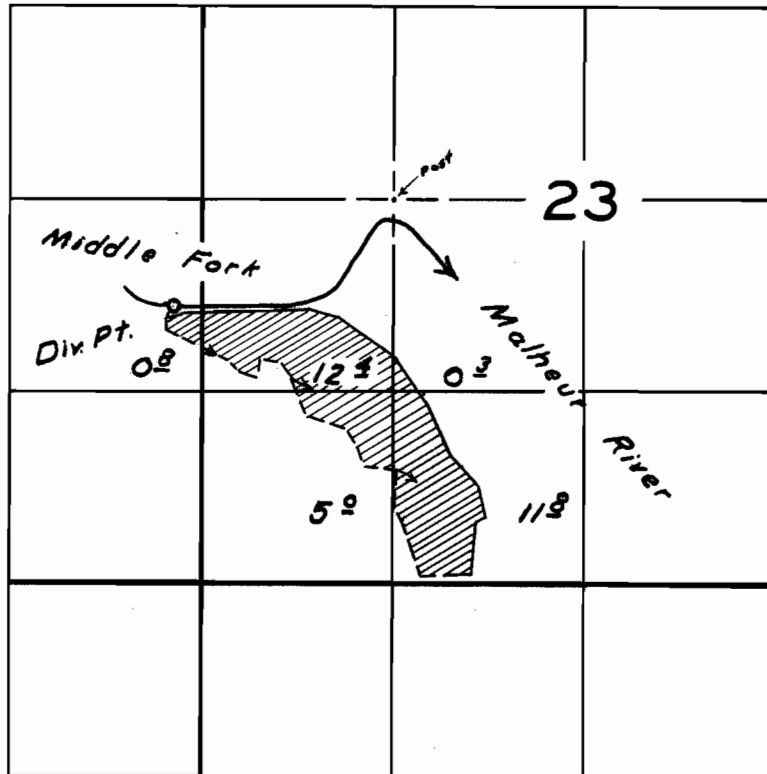

FINAL PROOF SURVEY
UNDER

Application No. 24945 Permit No. 19597
IN NAME OF

I. M. & Z. Percy Davis

Surveyed Aug. 20 1958, by W. N. Petty