


T. 39 S. R. 28 & 3 W. W.M.

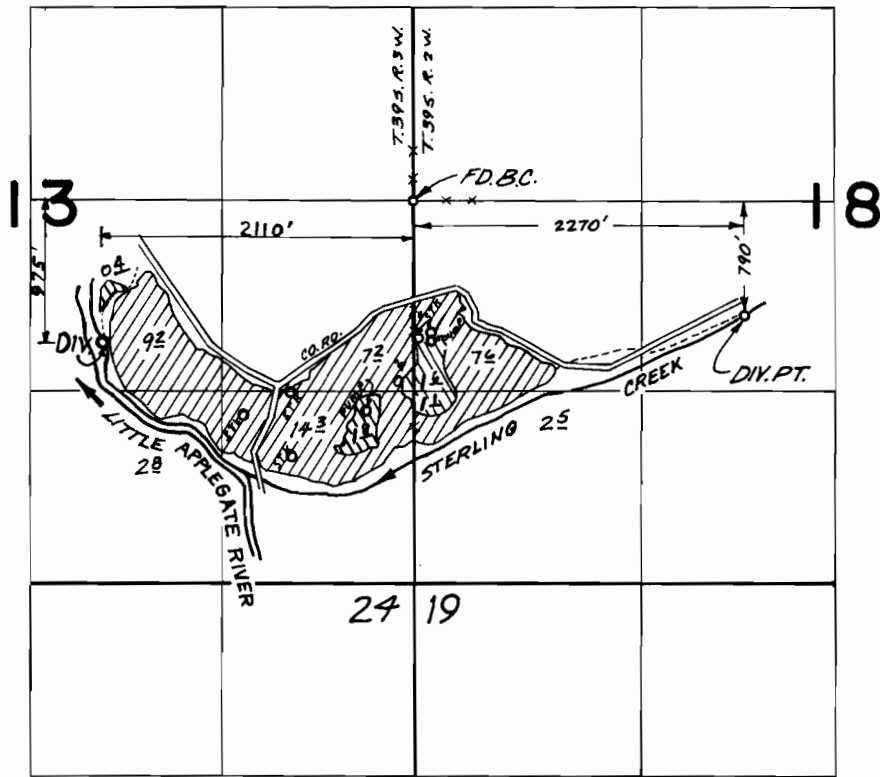

FROM APPLICANTS MAP - UPPER PHILLIPS DITCH DIV.:
680' S. & 9' W. FROM N 1/4 COR. SEC. 29, T. 39 S. R. 2 W.

FINAL PROOF SURVEY
UNDER

Application No. 48813 45011 Permit No. 36591 33636
IN NAME OF

LILLIAN F. HUKILL

Surveyed MAY 5 76 JULY 18 1974 by C.R. KING L.M. TOLL