


T.40S.,R.3W.,W.M.

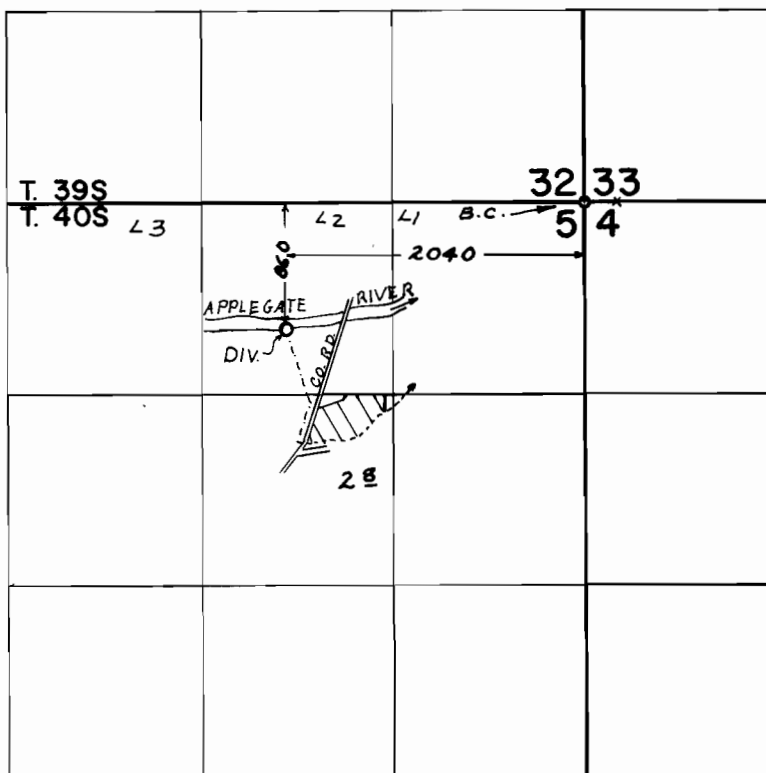

FINAL PROOF SURVEY
UNDER

Application No. 51698 Permit No. 38976
IN NAME OF

DAVID B. WINNINGHAM

Surveyed MAY 7 1976, by C.R. KING