


# T.37S.,R.6W.,W.M.

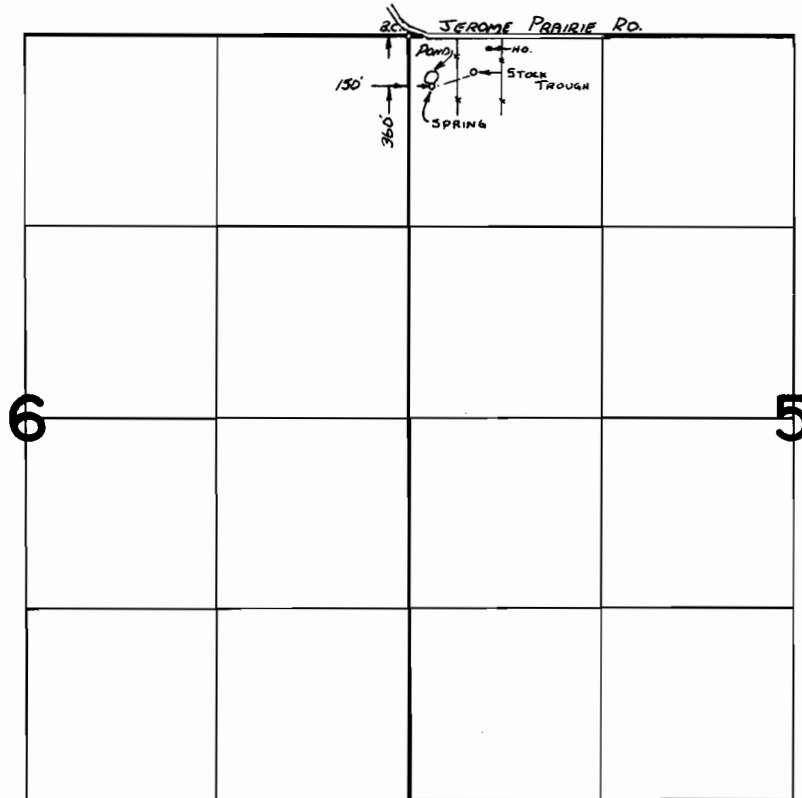

## FINAL PROOF SURVEY UNDER

Application No. 51026 Permit No. 38512  
IN NAME OF

LILLIAN A. SMITH

Surveyed MAY 4 1976, by L. TOLL