


T.23S.R.8W.W.M.

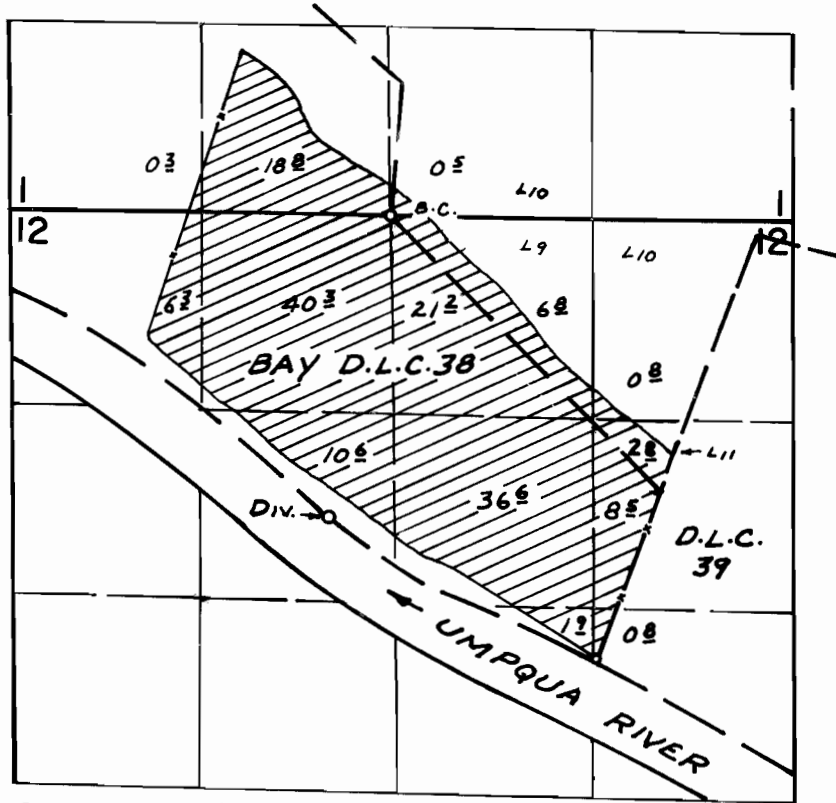

DIV. LOC: 2080' S. & 450' W. FROM N $\frac{1}{4}$ COR. SEC. 12

FINAL PROOF SURVEY UNDER

Application No. ~~44609~~ Permit No. ~~33424~~
IN NAME OF

CHARLES A. & VIRGIL K. KESTERSON

Surveyed *MAY 13 1976*, by *R. MUCKEN*