


G-3860

Sec. 6: G 8202

46055

T.37S.R.20E.W.M.

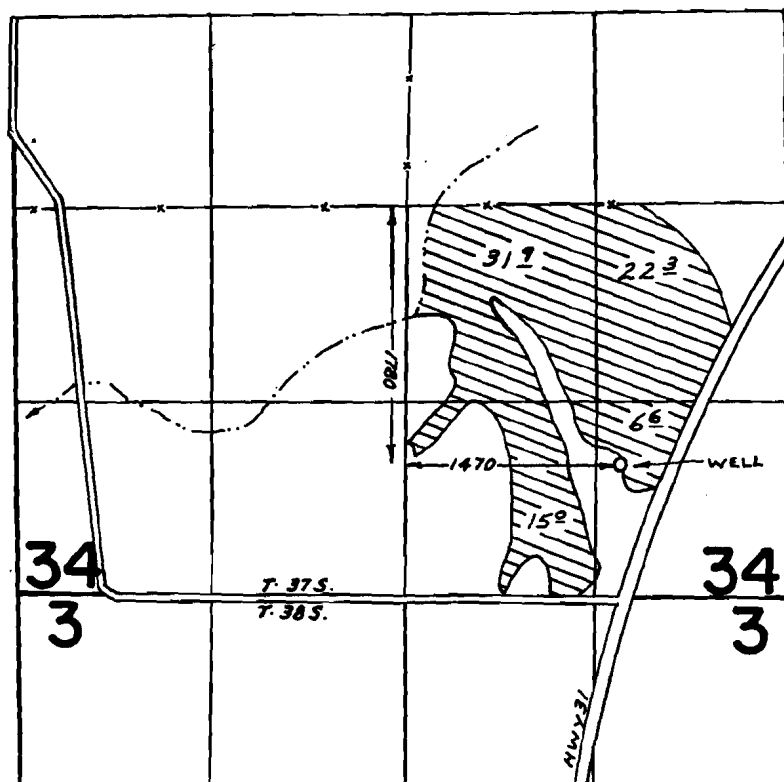

FINAL PROOF SURVEY
UNDER

Application No. G-4112 Permit No. G-3860.
IN NAME OF

.....ROBERT L. WEIR.....

Surveyed July 19, 1975, by L. NUNN.....
Nov. 1, 1976 by R. MUCKEN
APR. 24, 1978 by H. DAGGETT