


T.18S., R.11W., W.M.

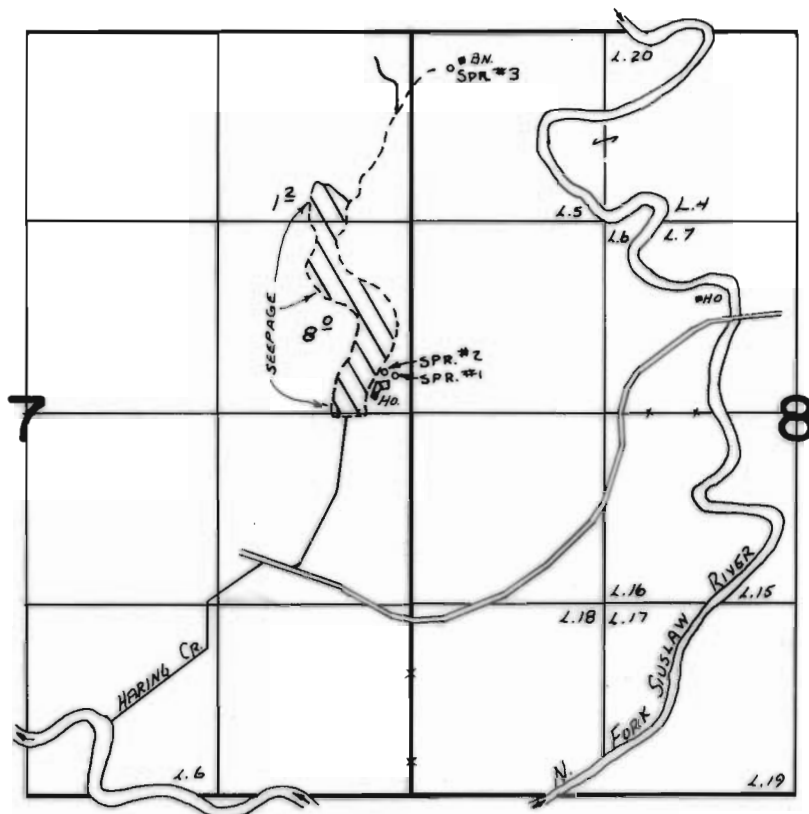

SPRING #1 - 250' N AND 110' W FROM E 1/4 COR SEC 7
SPRING #2 - 290' N AND 180' W FROM E 1/4 COR SEC 7
SPRING #3 - 250' S AND 270' E FROM NW COR SEC 8
SEEPAGE AREA - FROM A PT. 1430' N. & 700' W TO A PT. 550' W.
FROM E 1/4 COR. SEC. 7

FINAL PROOF SURVEY UNDER

Application No. 47738 Permit No. 35760
IN NAME OF

RUTH A. REESE

Surveyed SEPT. 14 1976, by L. TOLL