


T.17S. R.12W. W.M.

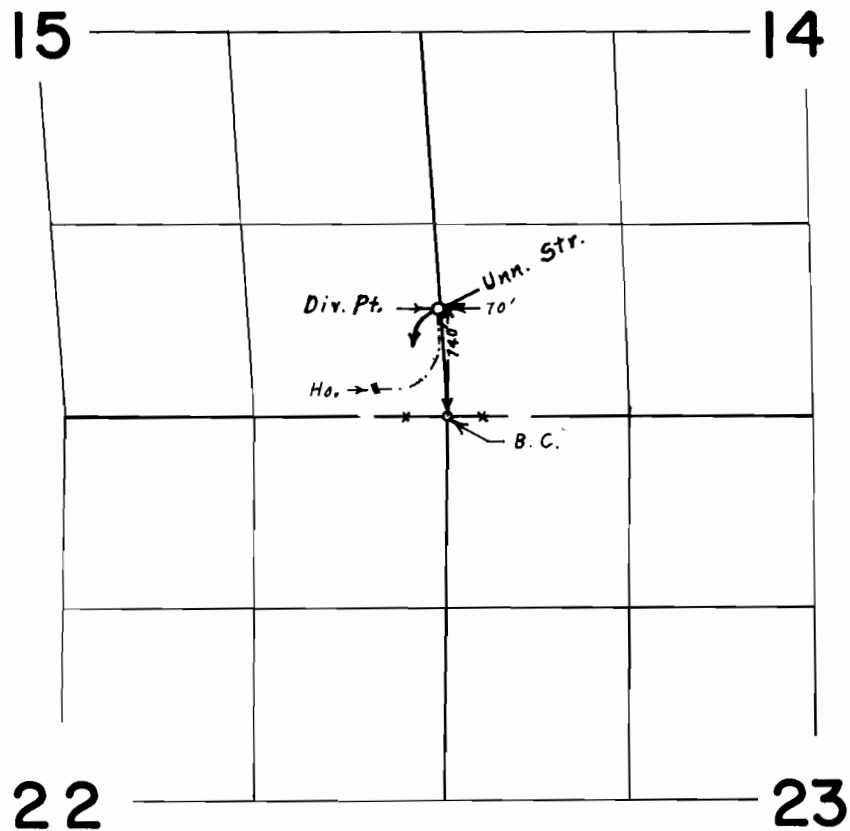

FINAL PROOF SURVEY
UNDER

Application No. 51163 Permit No. 37112
IN NAME OF

Ervin F. & Marjorie Berreth

Surveyed Aug. 2, 1976, by L. E. Gould