


T.18S. R.1W. W.M.

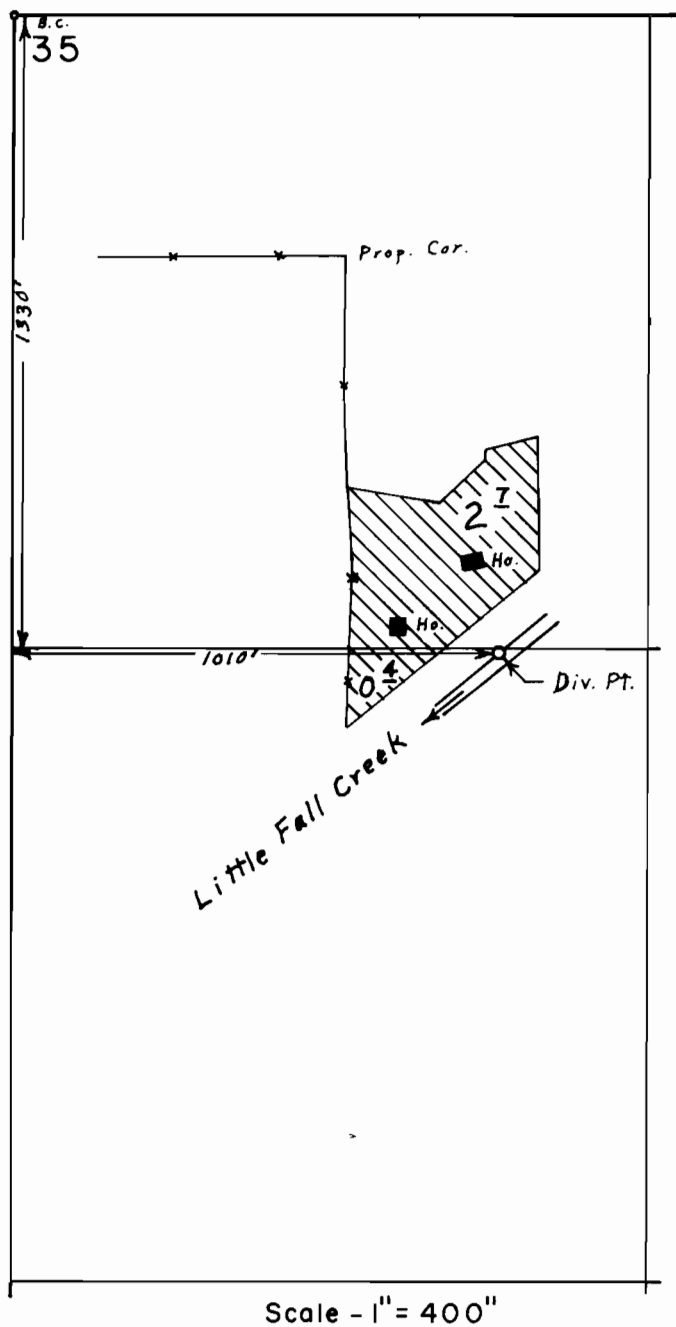

FINAL PROOF SURVEY
UNDER

Application No. 52374 Permit No. 39403
IN NAME OF

GLEN H. COLTRANE

Surveyed June 25, 1976, by L. E. Gould