


T.18S.,R.10W.,W.M.

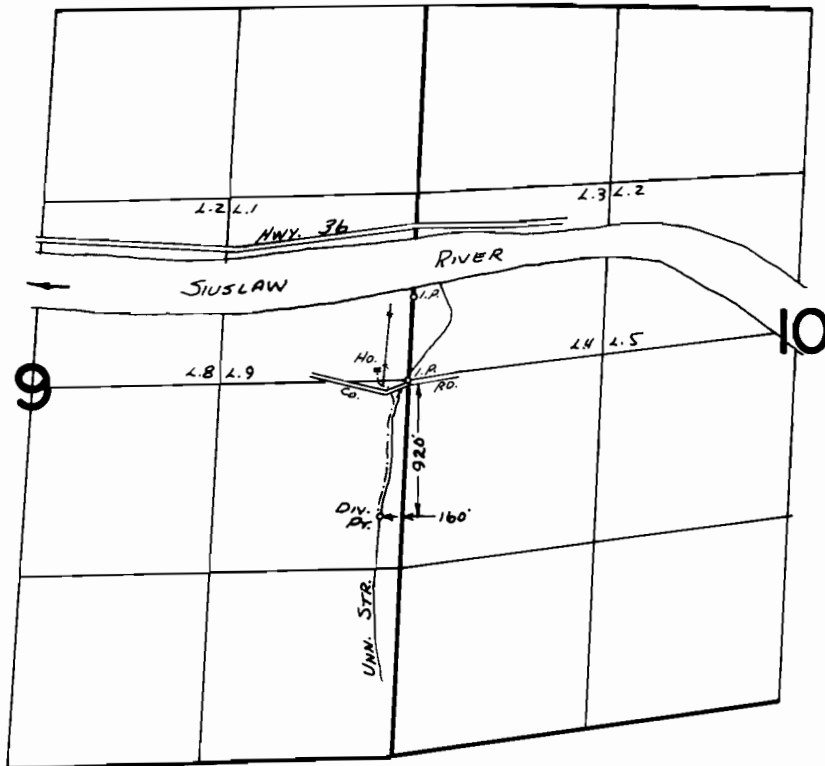

FINAL PROOF SURVEY UNDER

Application No. 52552 Permit No. 38202
IN NAME OF

BERNARD GROTH

Surveyed SEPT. 15, 1976, by L. TOLL