


T.18S., R.10W., W.M.

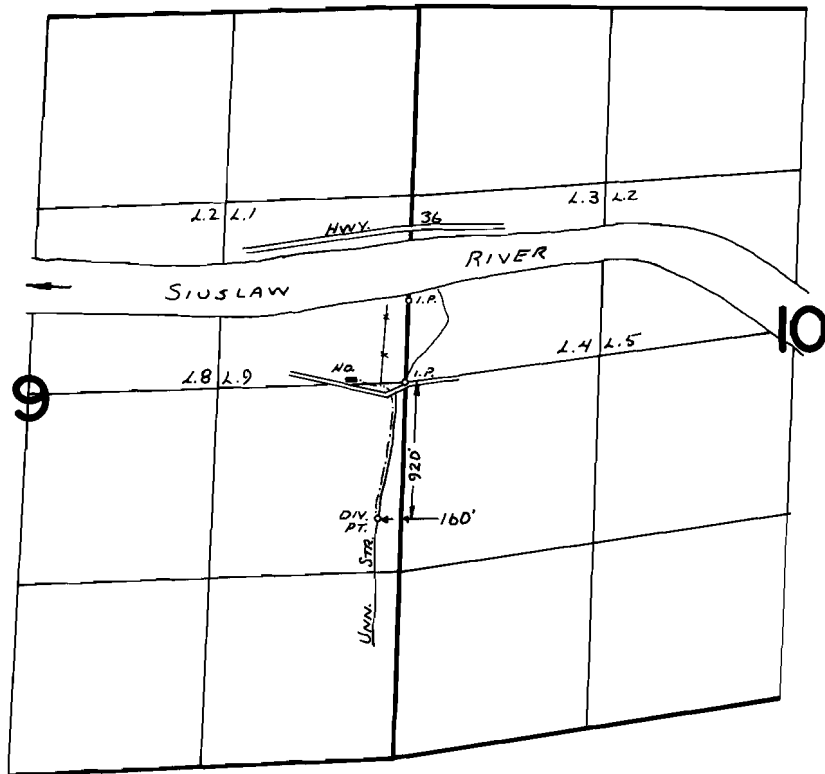

FINAL PROOF SURVEY
UNDER

Application No. 53315 Permit No. 39558
IN NAME OF

GEORGE H. BLACK

Surveyed SEPT. 15 1976, by L. Toll