


T.15S.R.6W.W.M.

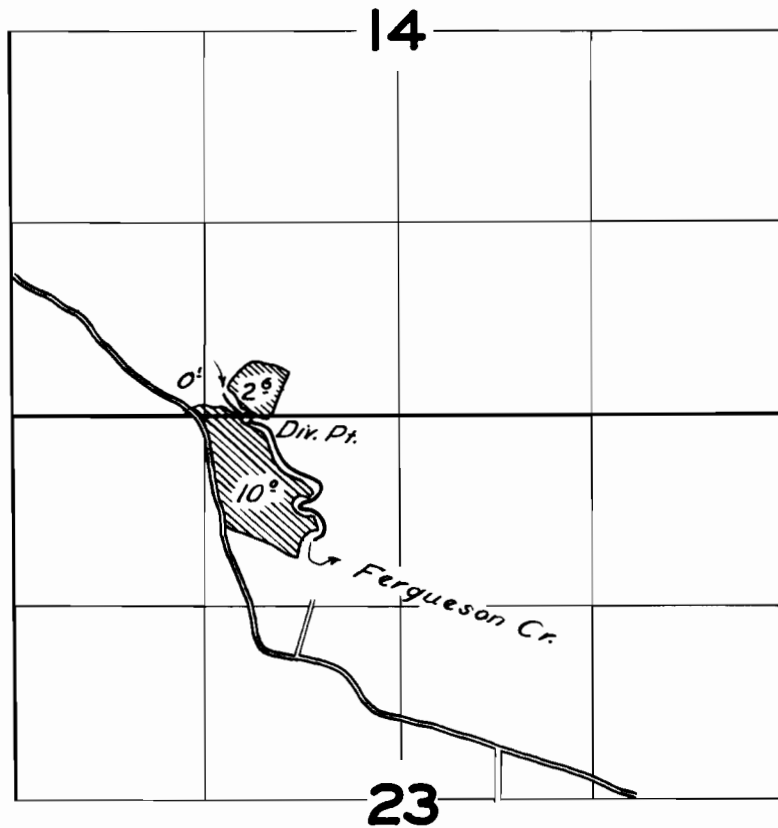

FINAL PROOF SURVEY
UNDER

Application No. 25463 Permit No. 20017
IN NAME OF

ROLLIN B. EVANS

Surveyed 19 Apr. 1957, by C. Whitely