


T.14S.,R.12W.,W.M.

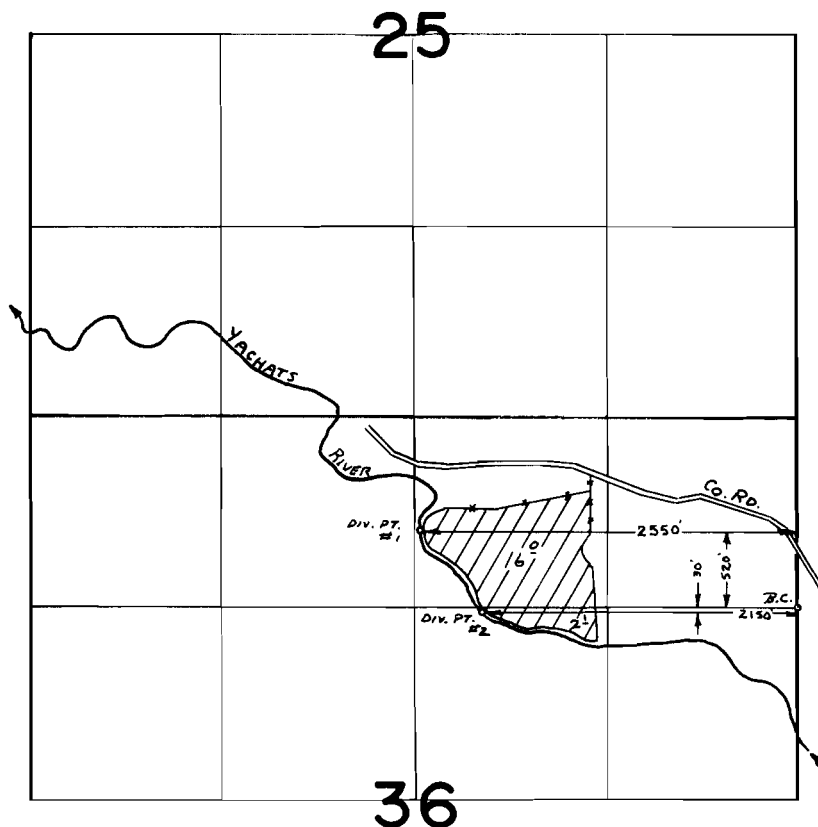

**FINAL PROOF SURVEY**  
UNDER

Application No. 45860 Permit No. 34240  
IN NAME OF

LEONARD CARSON

Surveyed Aug. 22, 1974, by D. NORBY  
SEPT. 8, 1975 L. Toll