


THS. RLOW. WM.

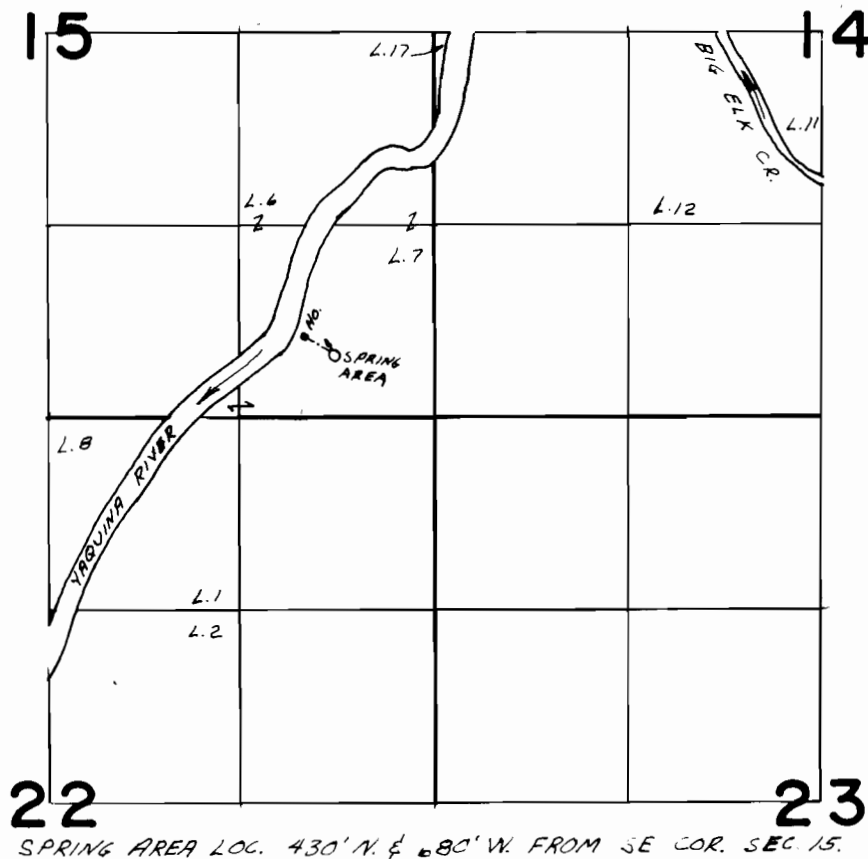

FINAL PROOF SURVEY UNDER

Application No. 46797 Permit No. 34993
IN NAME OF

V.L. January et al

Surveyed AUG. 11, 1976, by L.H. NUNN