


T.9&10S. R.10W. W.M.

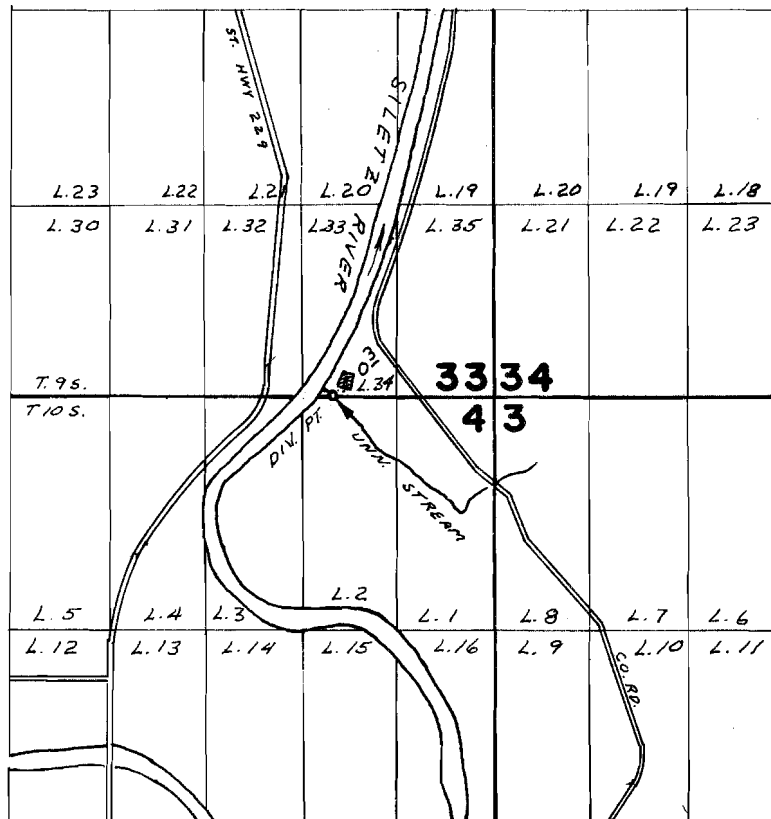

DIV. PT. LOC. 10' N. & 420' W. FROM S.E. COR. Lot 34

FINAL PROOF SURVEY UNDER

Application No. 48242... Permit No. 36226...
IN NAME OF

ARTHUR S. BENSELL

Surveyed OCT. 7... 1975., by L.H. NUNN