


T.I.S.R.I.W.W.M.

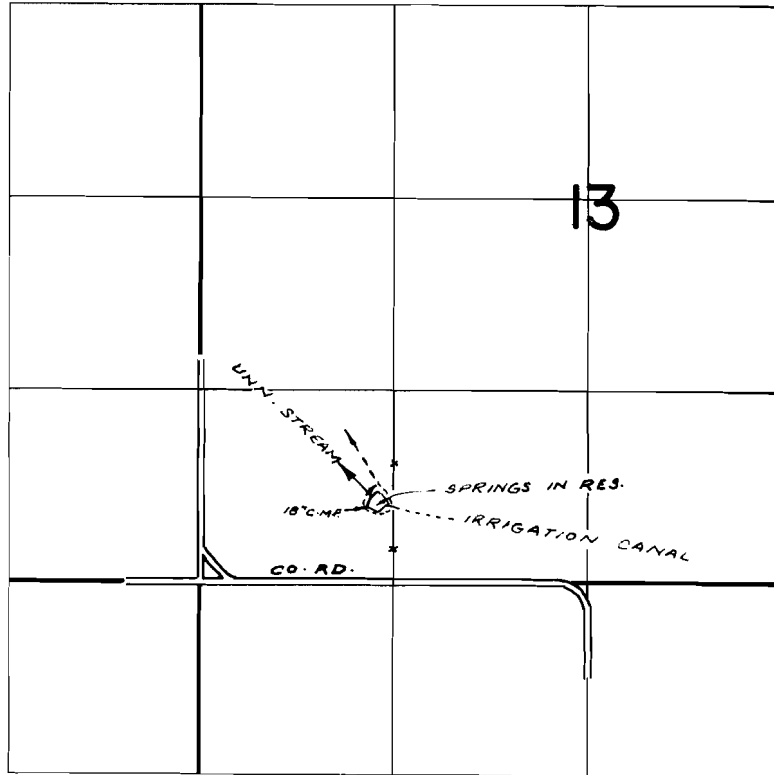

DIV. PT. LOC: 580' N. & 1170' E., FROM S.W. COR. SEC. 13

FINAL PROOF SURVEY UNDER

Application No. ⁴²¹⁸¹~~R-42182~~ Permit No. ³²⁸⁵⁶~~R-5063~~
IN NAME OF

.....CARL.....POWELL.....

Surveyed Nov. 8, 1972, by R. MUCKEN