

W.R. 1054

MRS. DORA HORNER
RAY & LUCILLE BRANNAN

SEC. 31, T. 9 S., R. 4 E., W.M.

LINN COUNTY, OREGON

Scale: 1" = 400'

April 27, 1973

Orris A. Carnegie


County Surveyor

*This map drawn from County
Records and air photos.*

REGISTERED
PROFESSIONAL
LAND SURVEYOR

Orris A. Carnegie

OREGON
MAY 9, 1947
ORRIS A. CARNEGIE
213

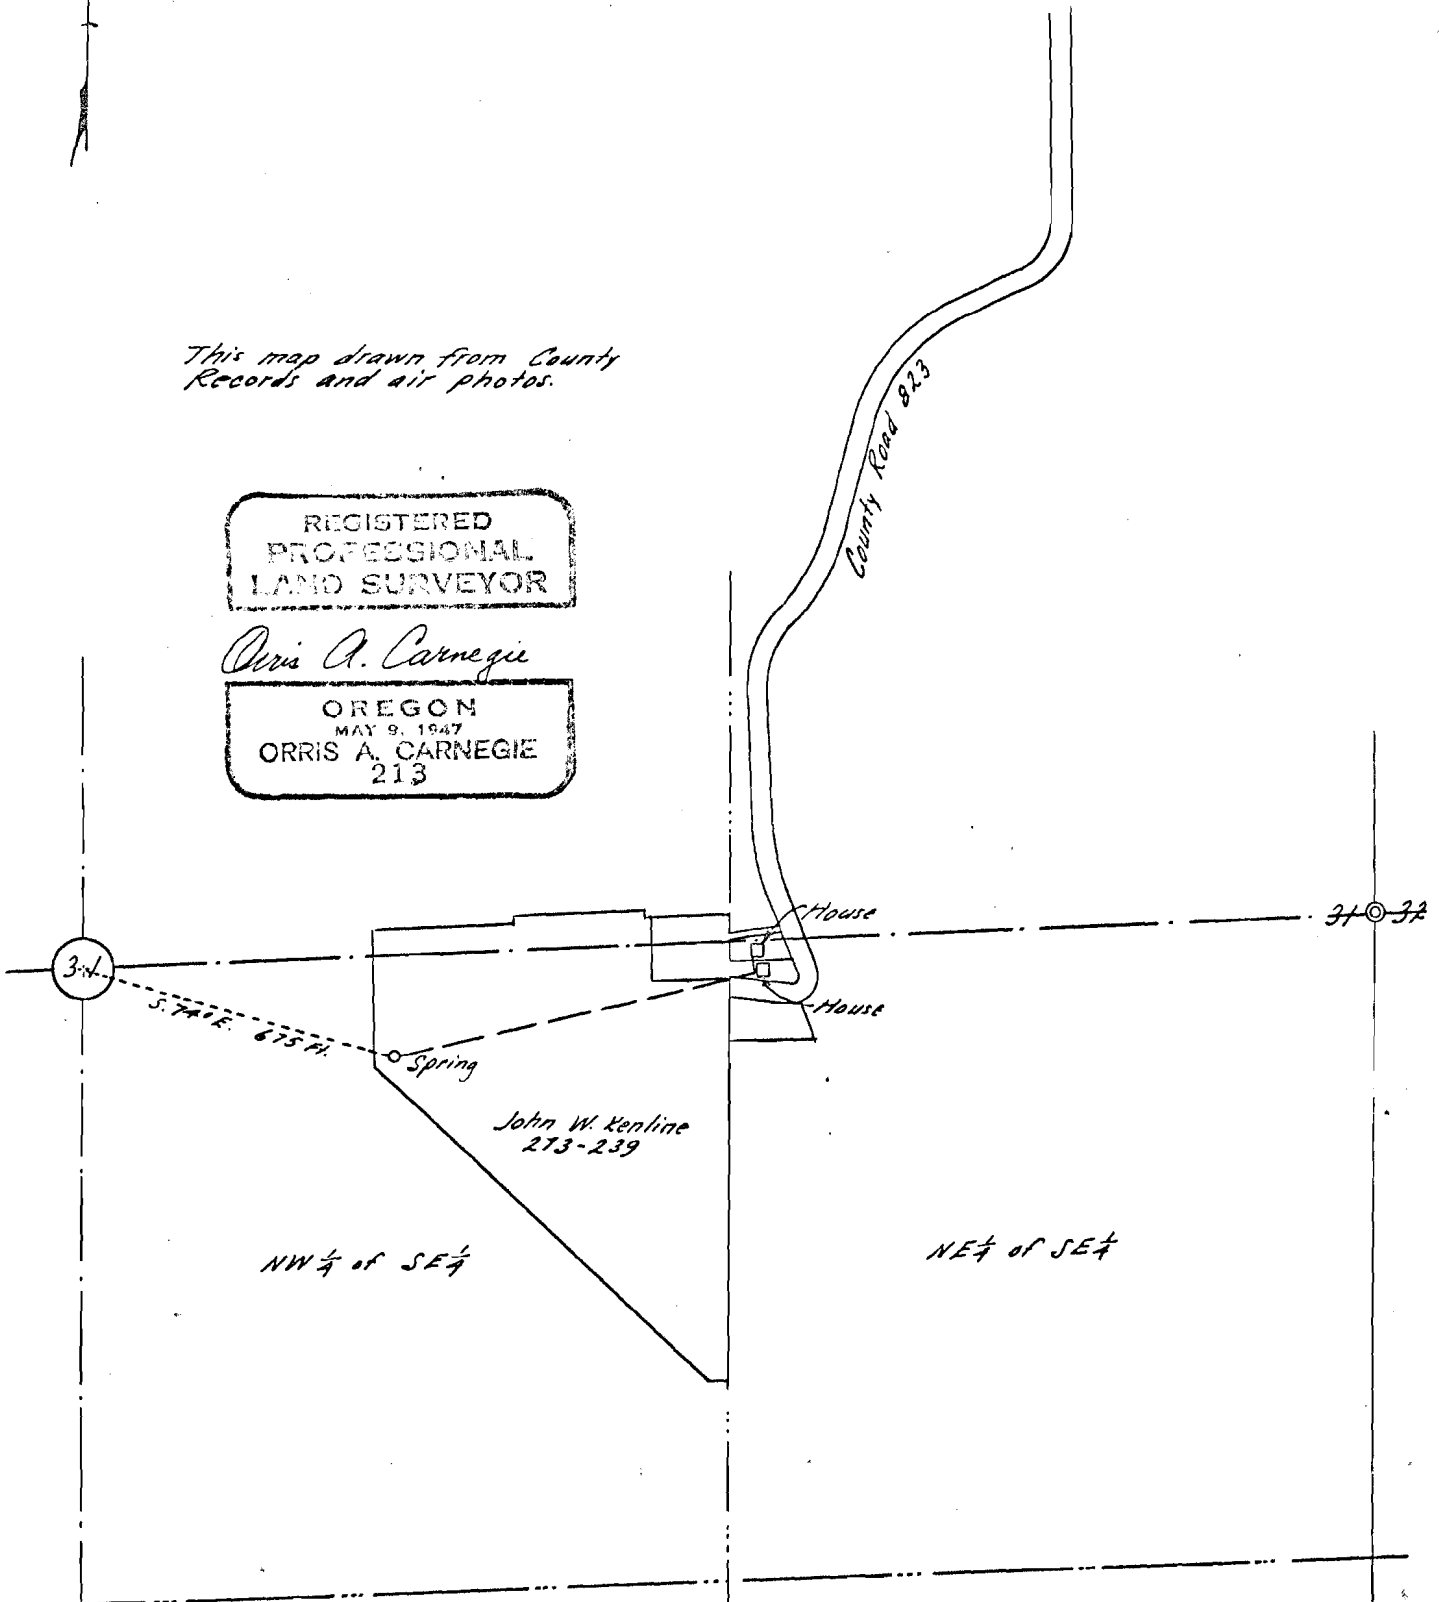

Application No. 50398

Permit No. 38038