


# T.12S., R.4W., W.M.

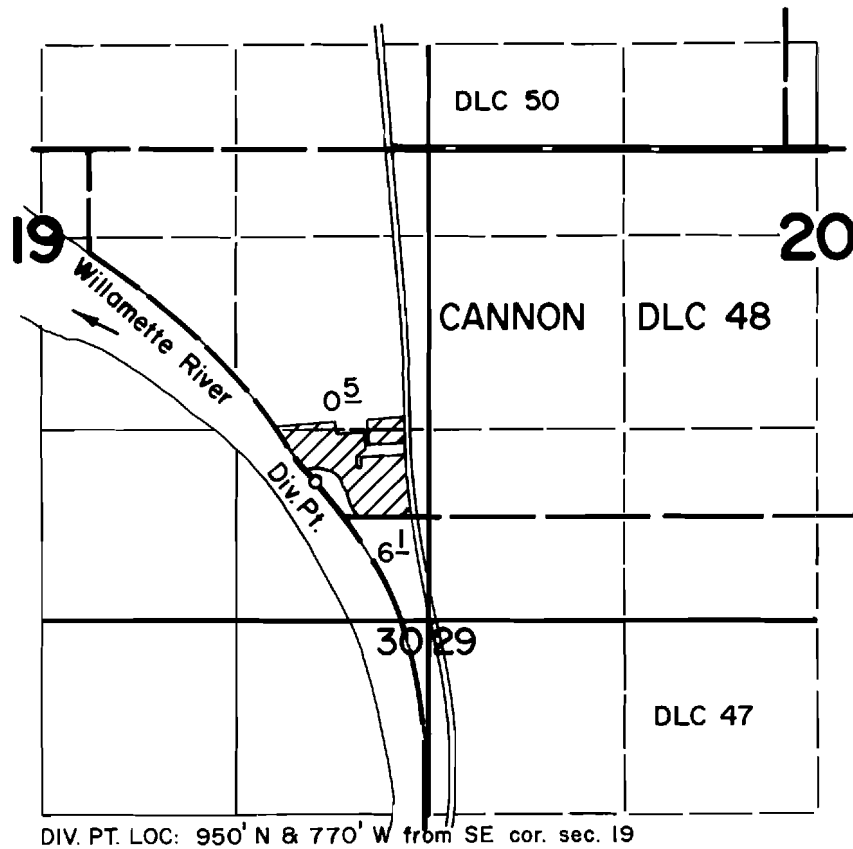

## FINAL PROOF SURVEY UNDER

Application No. 51081 Permit No. 38540  
IN NAME OF

EDWIN ROHNER

Surveyed April 13 1976, by D. Norby