


T. 30 S. R. 46 E. W.M.

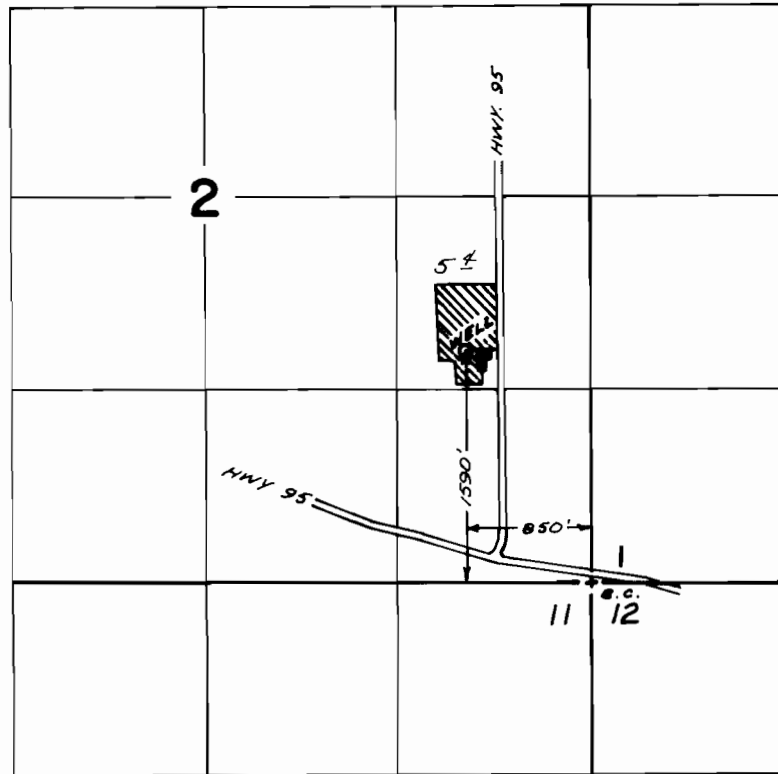

FINAL PROOF SURVEY
UNDER

Application No. G-5743 Permit No. G-5536

IN NAME OF
MALHEUR COUNTY
UNION HIGH SCHOOL NUMBER 1

Surveyed JUNE 11, 1976, by L.E. GOULD