


T.27S. R.46E. W.M.

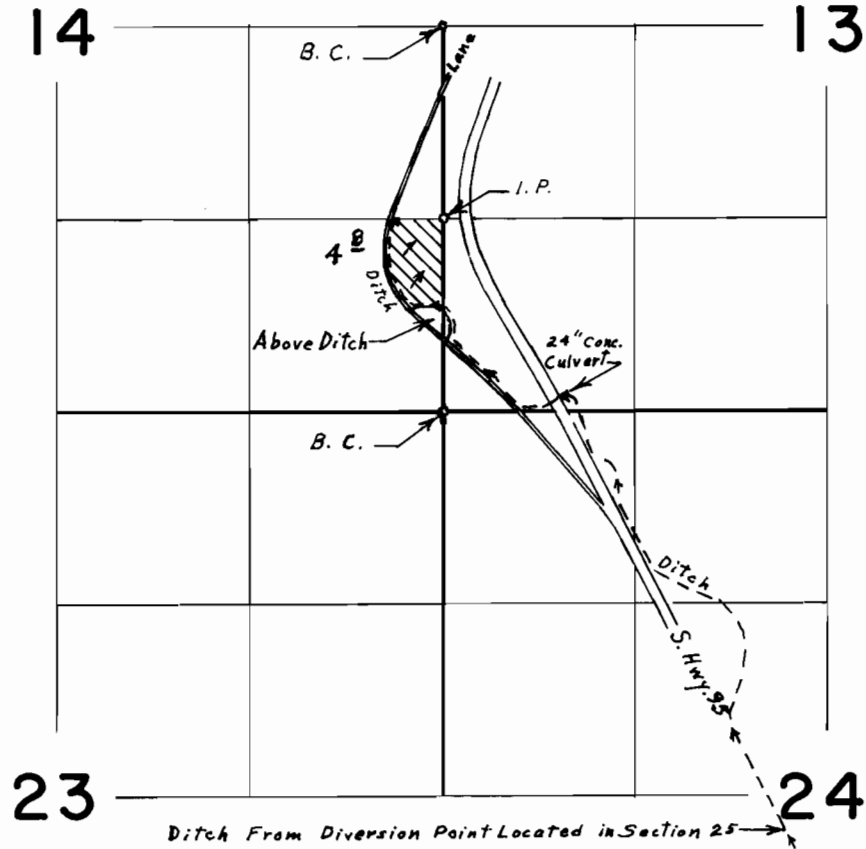

FINAL PROOF SURVEY

UNDER


MAP #2 of 2

Application No. 36098... Permit No. 27637...
IN NAME OF

JOSEPH S. FENWICK

Surveyed June 12, 1976, by L. E. Gould

T.27S. R.46&47E. W.M.

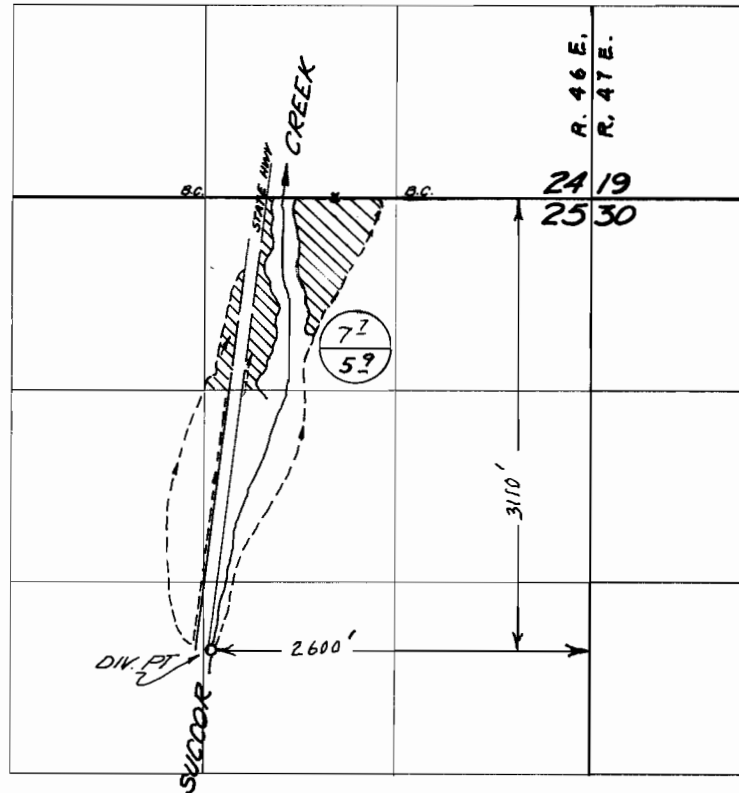

PERMIT 27637
CERT. 30859

FINAL PROOF SURVEY
UNDER

MAP #1 of 2

Application No. 36098 Permit No. 27637
IN NAME OF

JOSEPH S. FENWICK

Surveyed Oct. 26, 1968, by V. Garner