


T.20S. R.41E. W.M.

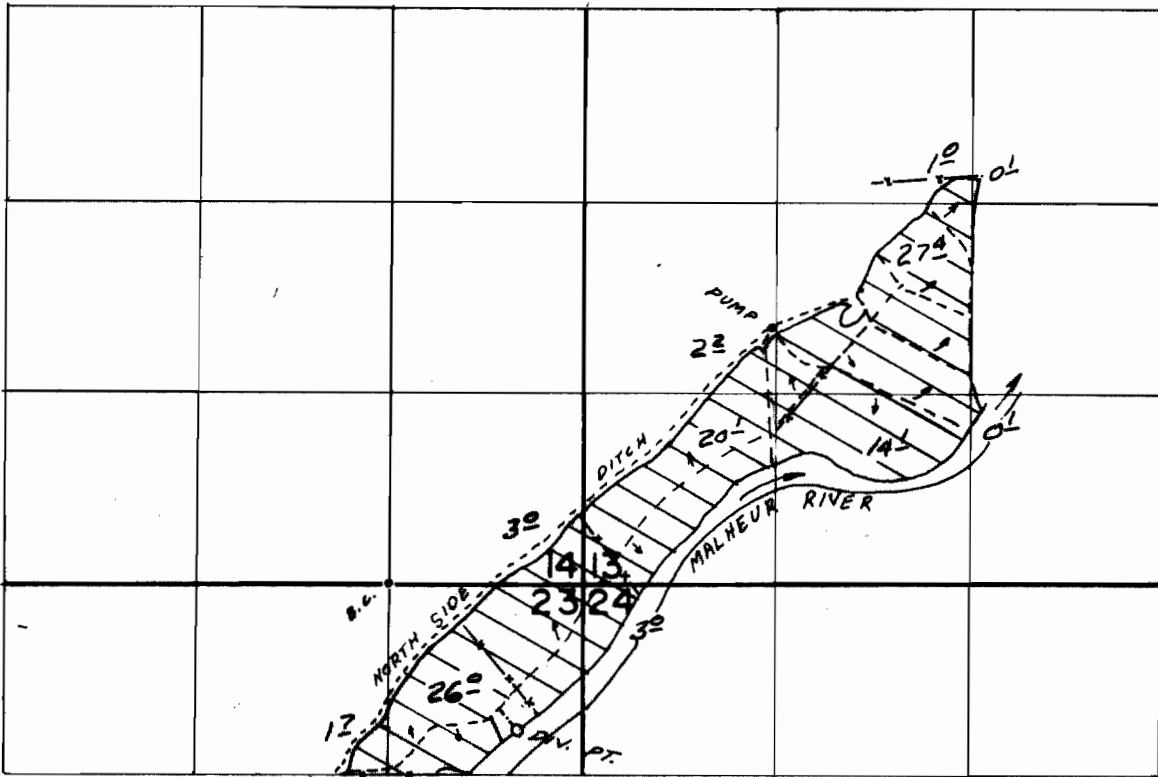

DIV. PT. LOC. 1000' S. & 880' E FROM NW COR. NE 1/4 NE 1/4, SEC. 23

FINAL PROOF SURVEY UNDER

Application No. 49142... Permit No. 37152...
IN NAME OF

LOREN MILLER

Surveyed MAY 12... 1975, by L.H. NUNN.....