


T.9S.,R.2E.,W.M.

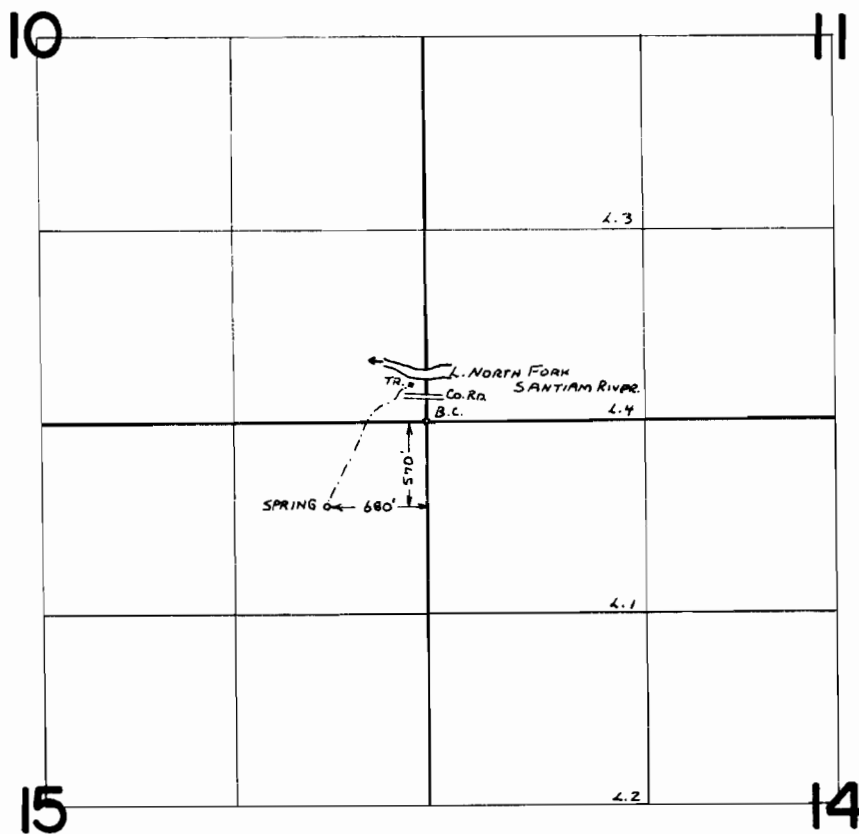

FINAL PROOF SURVEY
UNDER

Application No. 48792 Permit No. 36577
IN NAME OF

ELLIS B. & ROBERT C. WHITE

Surveyed SEPT. 5 1975, by L. Tell