


T.4S.,R.1W.,W.M.

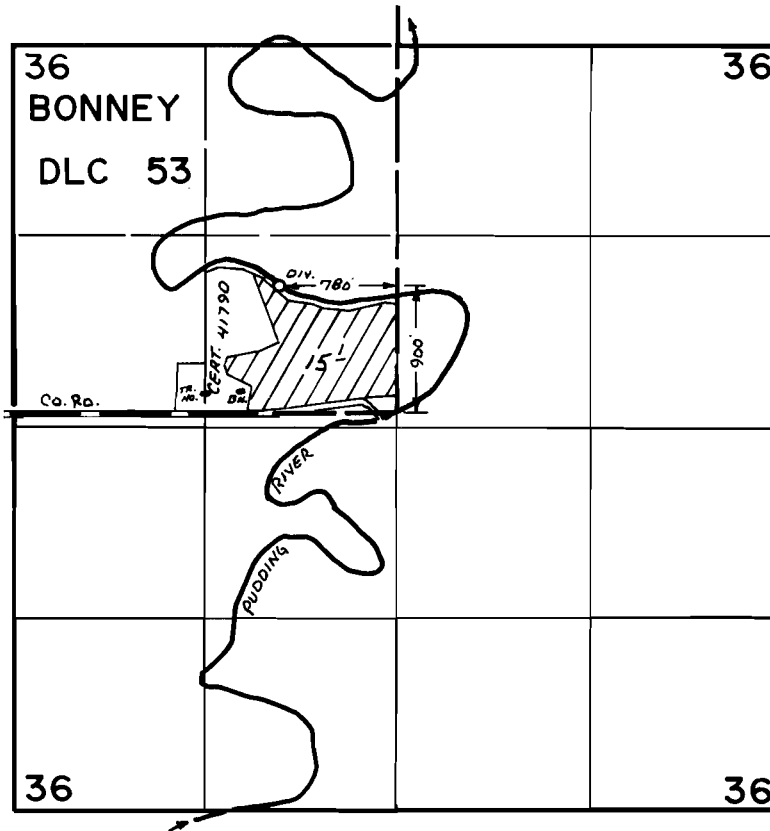

FINAL PROOF SURVEY UNDER

Application No. ...50171... Permit No. ...37879..
IN NAME OF

.....GERALD L. LARSON.....

Surveyed JUNE 3, 1976, by L. TOLL.....