



T2 & 3N. R.27E. W.M.

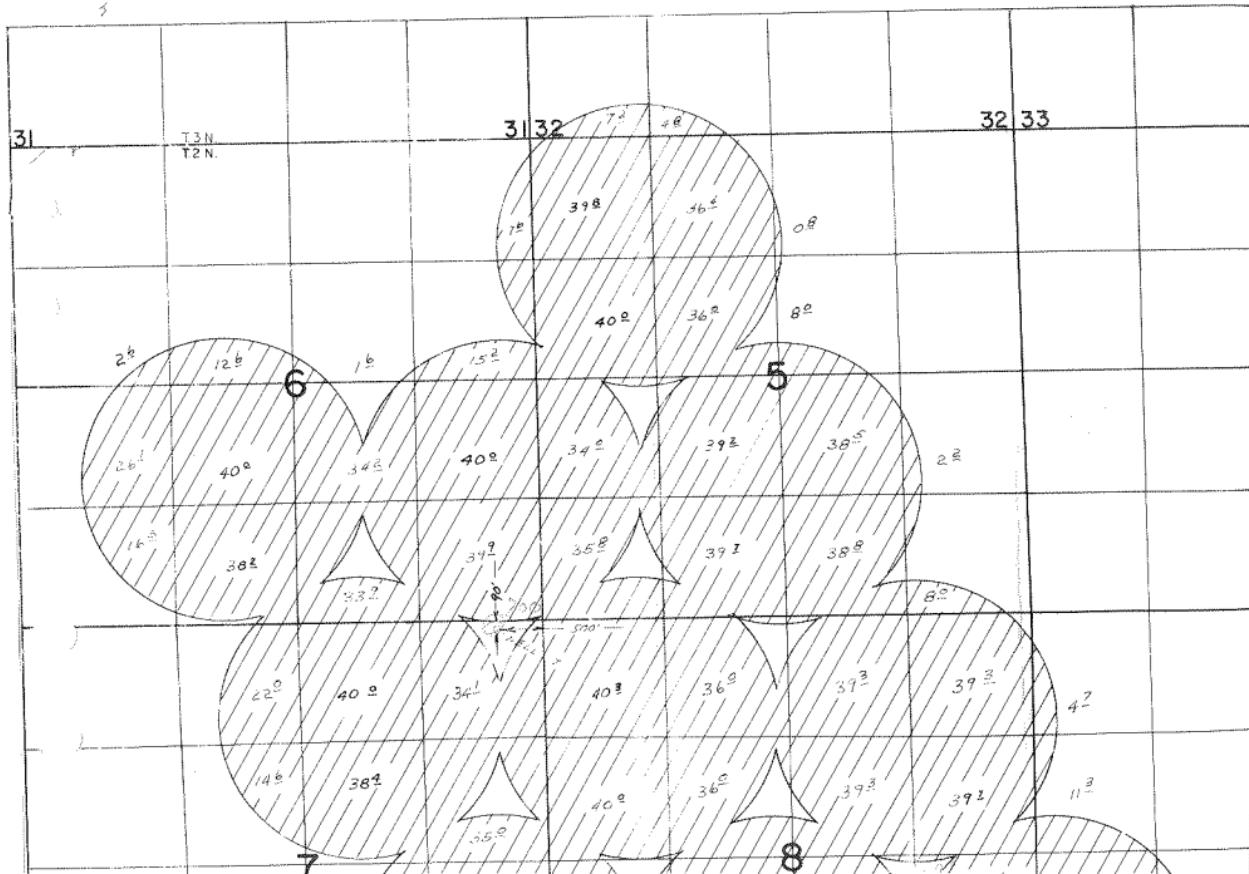

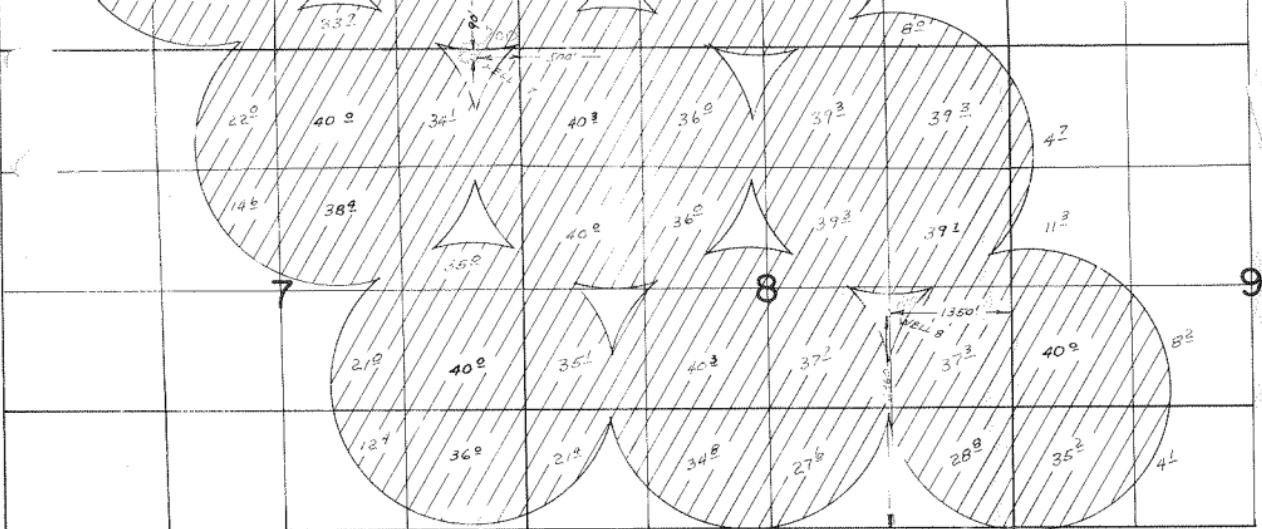

FINAL PROOF SURVEY

UNDER

APPLICATION NO. G-4601 PERMIT NO. G-4325

IN THE NAME OF

PORTER-PERINGER, INC.

SURVEYED JUL. 22, 1976, BY L.H. NUNN