


T. 3S. R. 26E. W.M.

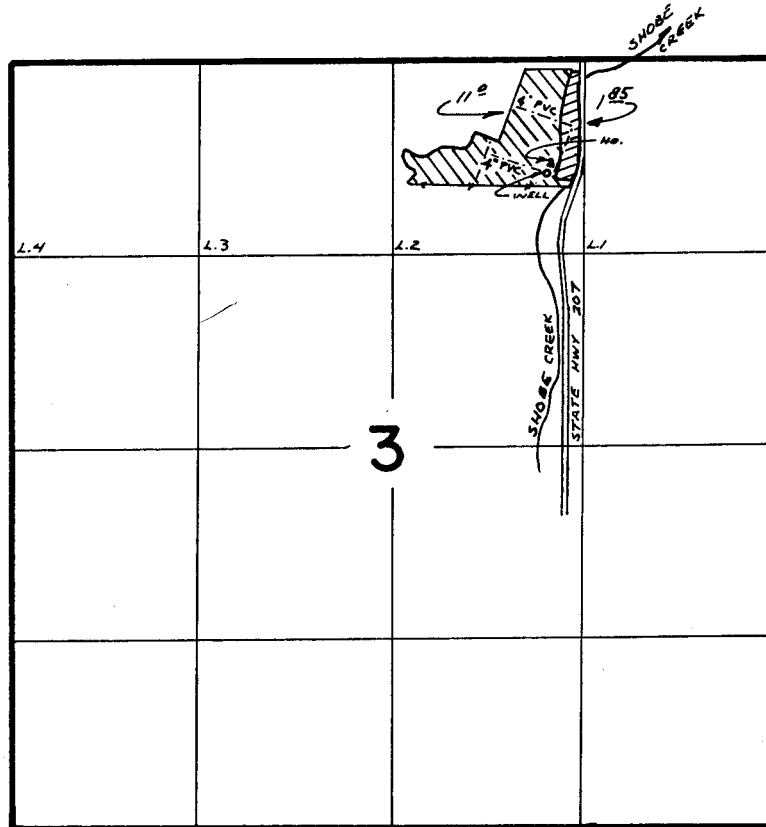

WELL LOCATED 780' S. & 1540' W. FROM NE COR SEC 3

FINAL PROOF SURVEY
UNDER

Application No. G.6896 Permit No. G.6425
IN NAME OF

HOWARD L. PETTY JOHN

Surveyed DEC. 12, 1977, by R. BARWIN