


T.7S. R.5W. W.M.

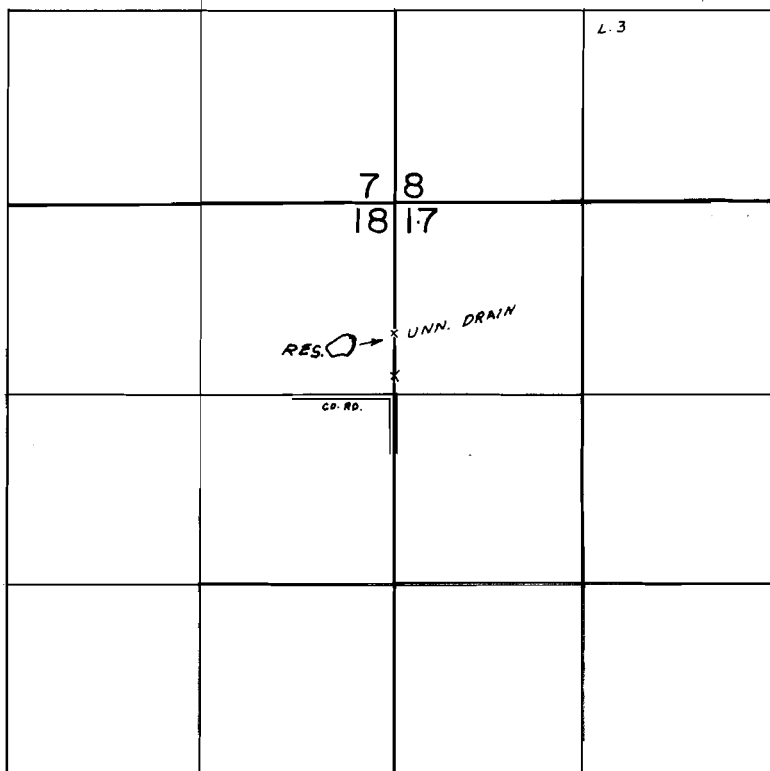

RES. LOC. 970'S & 290' W FROM NE COR. SEC. 18

FINAL PROOF SURVEY
UNDER

R-48213 R-5650
Application No. 48214 Permit No. 35247
IN NAME OF

..... JAMES A. DOMASCHOFSKY

Surveyed APR. 15. 1975, by L.H. NUNN