


G-6360
46099

T.1S., R.32E., W.M.

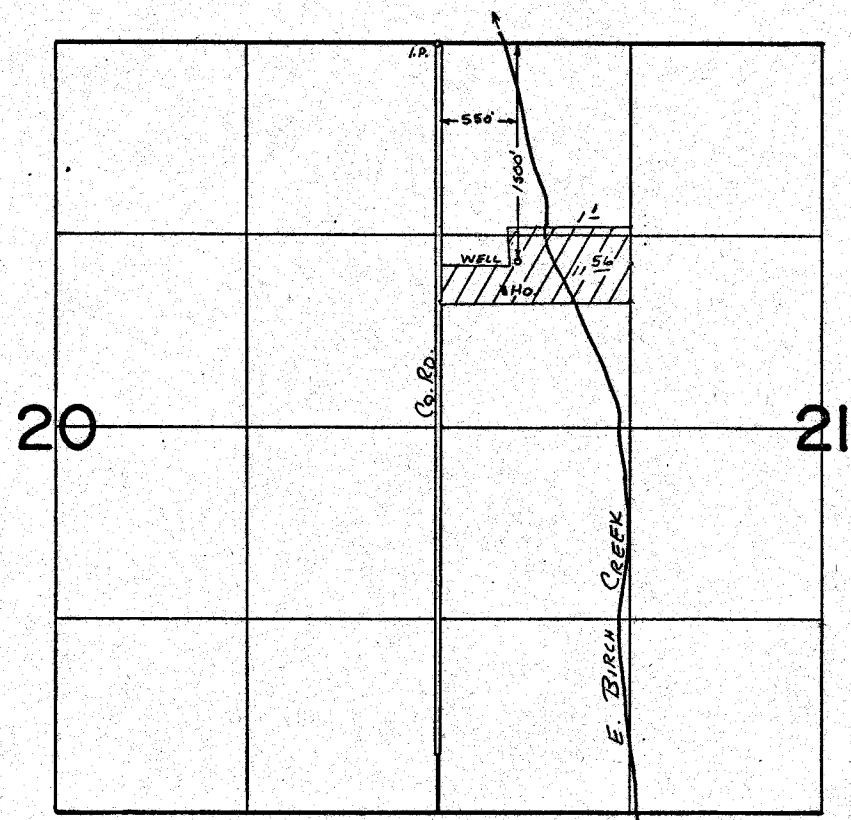

FINAL PROOF SURVEY UNDER

Application No. ..G:7081. Permit No. ..G:6360.
IN NAME OF

.....THOMAS.....J.....MULENBURG.....

Surveyed *April 13* 1976., by *L. Toll*.....