


T.1S.,R.33E.,W.M.

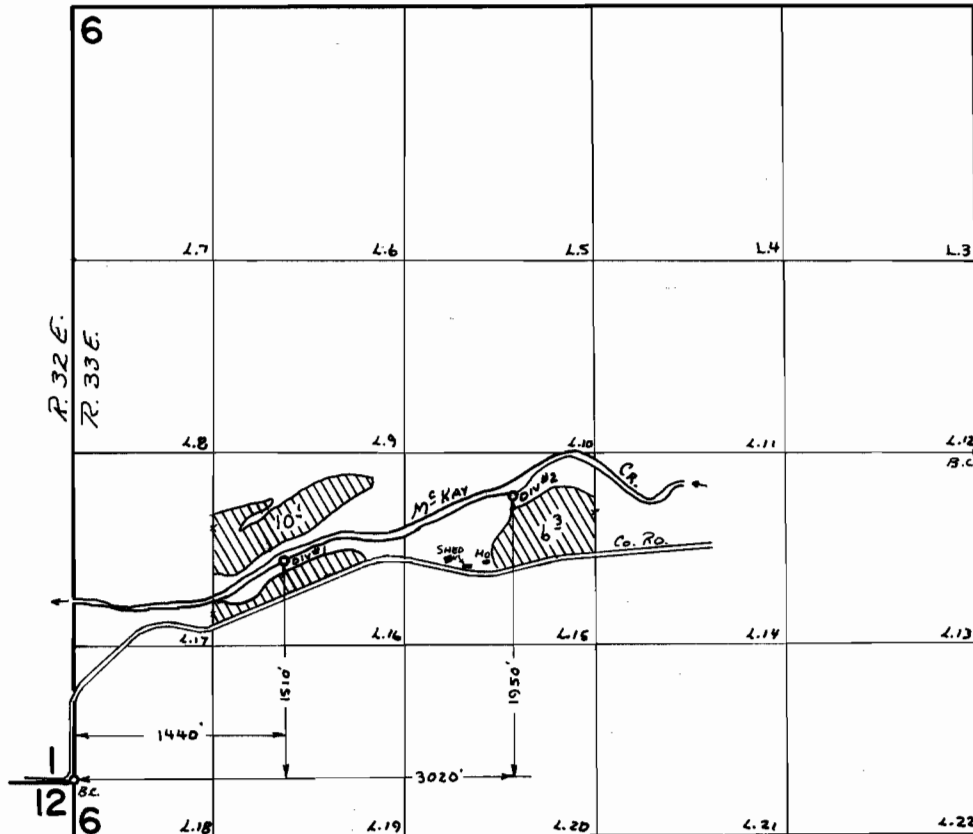

FINAL PROOF SURVEY UNDER

Application No. 44464 Permit No. 33257
IN NAME OF

RICHARD V. & JANIECE HELEN STANHOPE

Surveyed APRIL 7 1975, by L. Toll