


T. 2N. R. 34E. W.M.

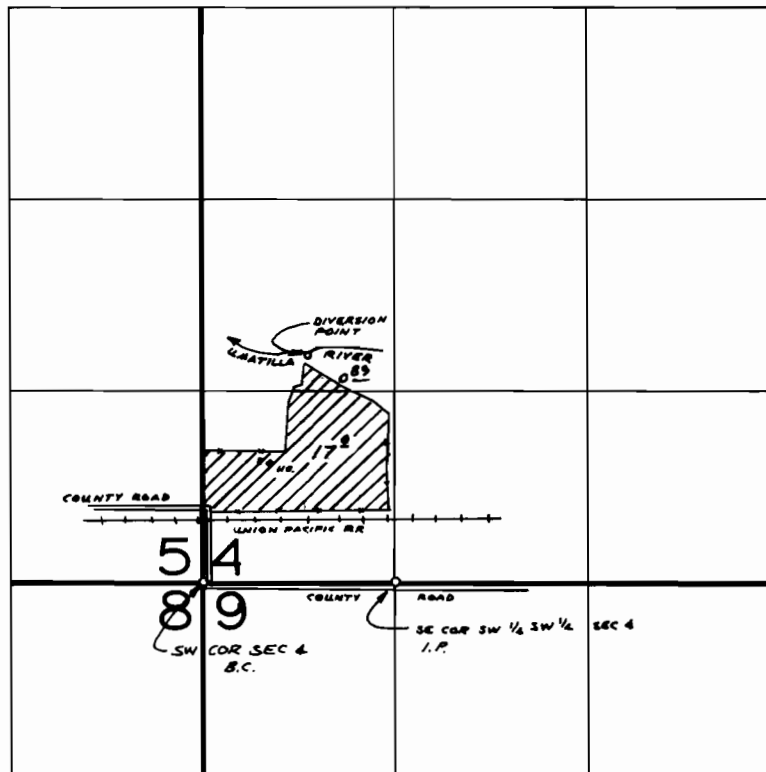

DIVERSION POINT LOCATED 1560' N. & 720' E. FROM SW COR SEC 4

**FINAL PROOF SURVEY**  
UNDER

Application No. 52556 Permit No. 39653  
IN NAME OF

JAMES & JERRI BEALER

Surveyed OCT 6 1977, by R. BARWIN