


T.1S. R.3W. W.M.

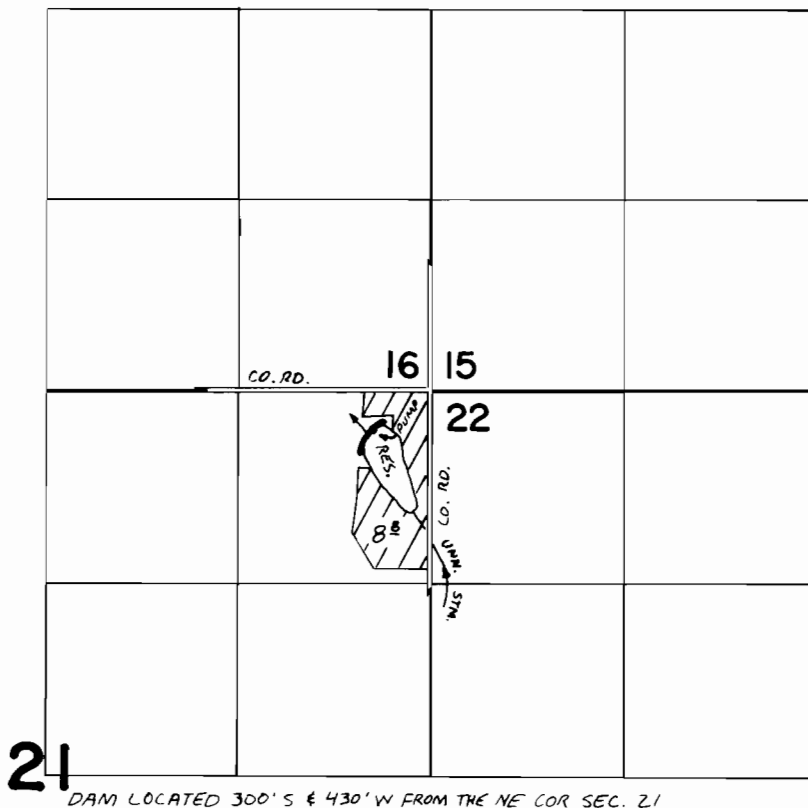

FINAL PROOF SURVEY UNDER

Application No. R-46287 Permit No. R-5442
46291 34208
IN NAME OF

AMFAC NURSERIES, INC.

Surveyed OCT. 1 1976, by L. E. GOULD