


T. 1 S. R. 4 W. W. M.

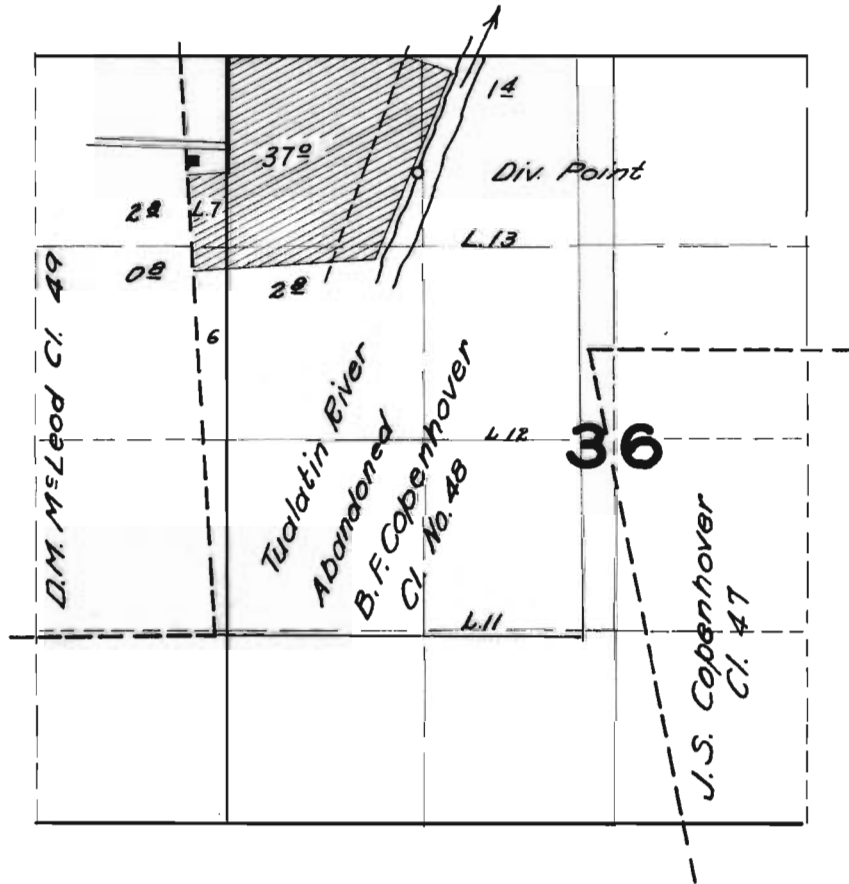

FINAL PROOF SURVEY

UNDER

Application No. **22538** Permit No. **17752**

IN NAME OF

A. J. BERRY

Surveyed APR. 2, 1950, by H. L. COFFMAN