


T.5S. R.4W. W.M.

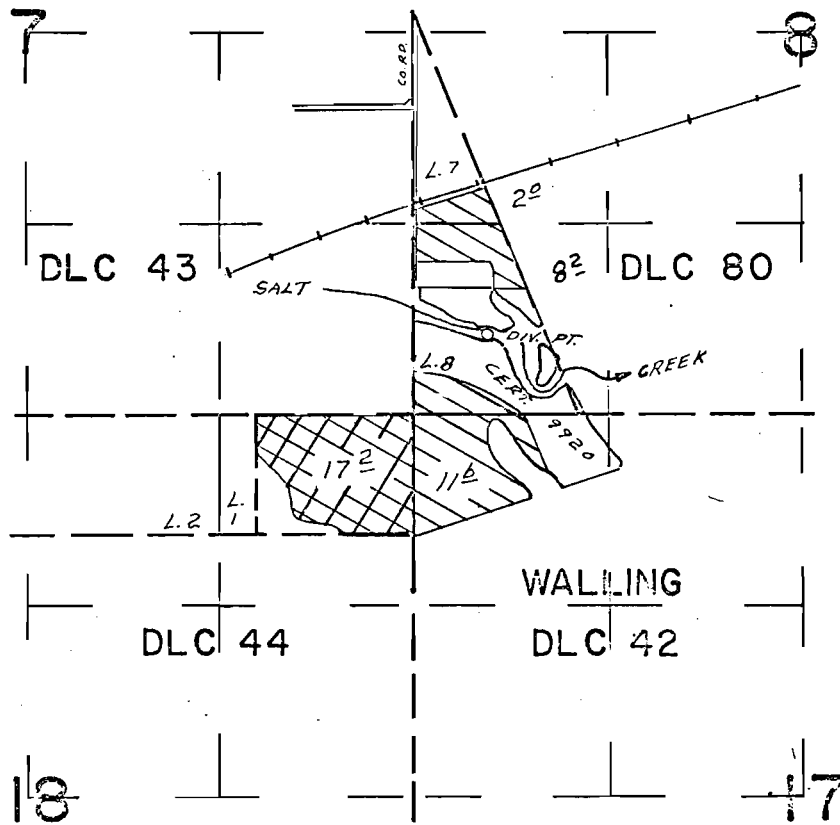

DIV. PT. LOC. 550' N. & 500' E. FROM SW COR. SEC. 8


FINAL PROOF SURVEY
UNDER

49246

36909



Application No. 41995..... Permit No. 31429.....

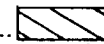

IN NAME OF

Melvin E. & Mary J. Trammel.....

Surveyed AUG. 11, 1977, by L.H. NUNN.....