


T.5S. R.4W. W.M.

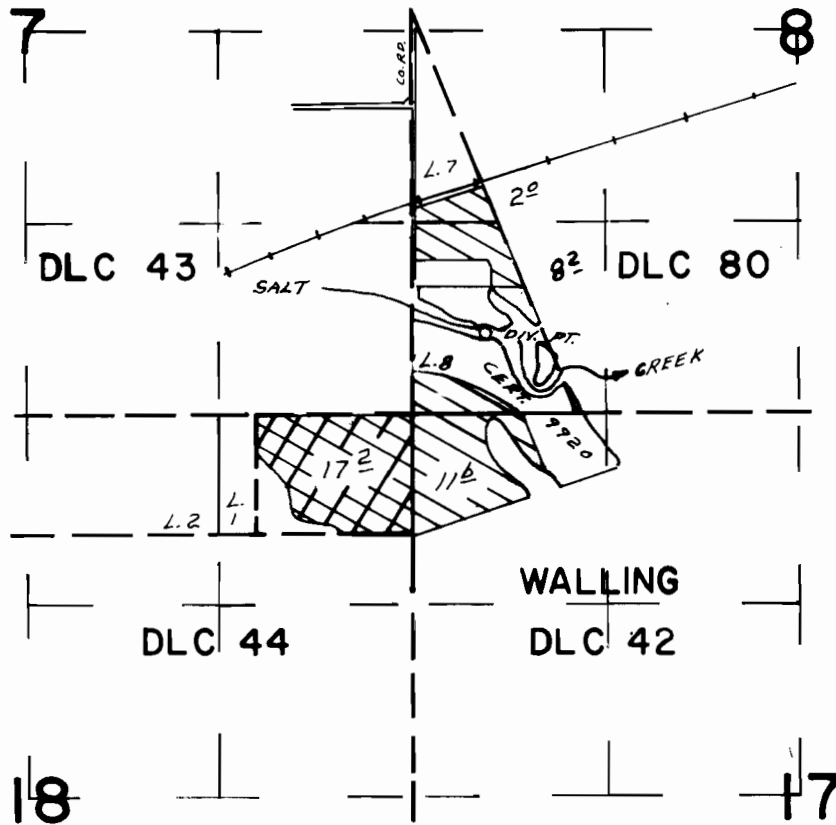

DIV. PT. LOC. 550' N. & 500' E. FROM SW COR. SEC. 8

FINAL PROOF SURVEY
UNDER

49246

36909



Application No. 41995..... Permit No. 31429.....
IN NAME OF



Melvin E. & Mary J. Trammel.....

Surveyed AUG. 11. 1977., by L.H. NUNN.....