


T.4S. R.5W. W.M.

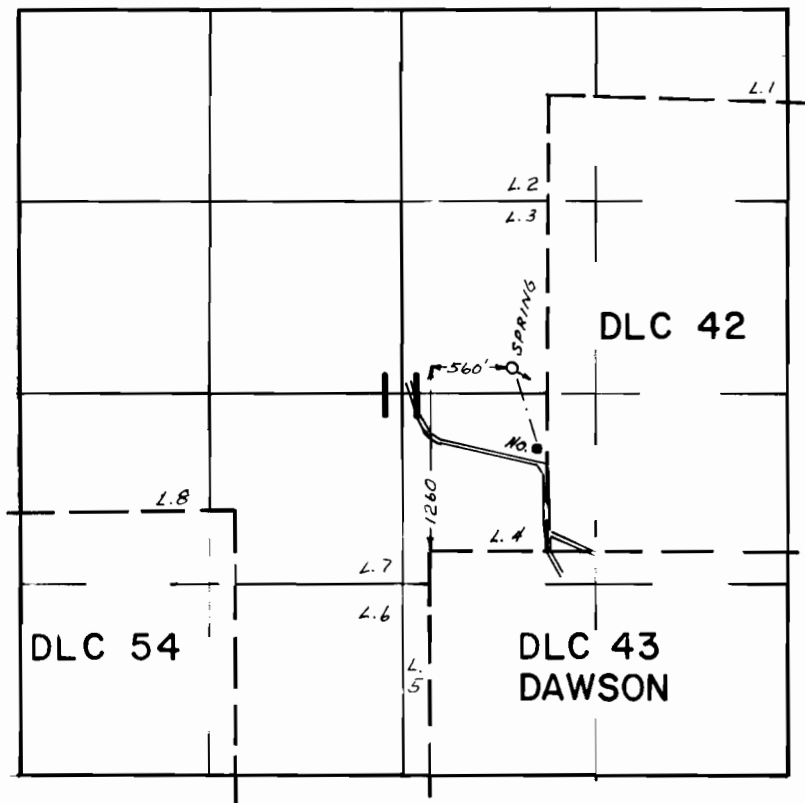

FINAL PROOF SURVEY
UNDER

Application No. 52448... Permit No. 39445...
IN NAME OF

Francis E. Mather

Surveyed AUG. 11, 1977, by L.H. NUNN