
T.7S. R.38E.W.M.

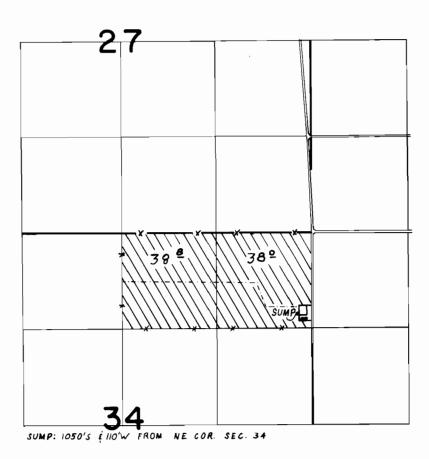

FINAL PROOF SURVEY

Application No. G-3897 Permit No. G-3662 IN NAME OF
M. GRANT LINDSAY
Surveyed JUNE 24 1976, by C.R. KING