


# T.8S., R.38E., W.M.

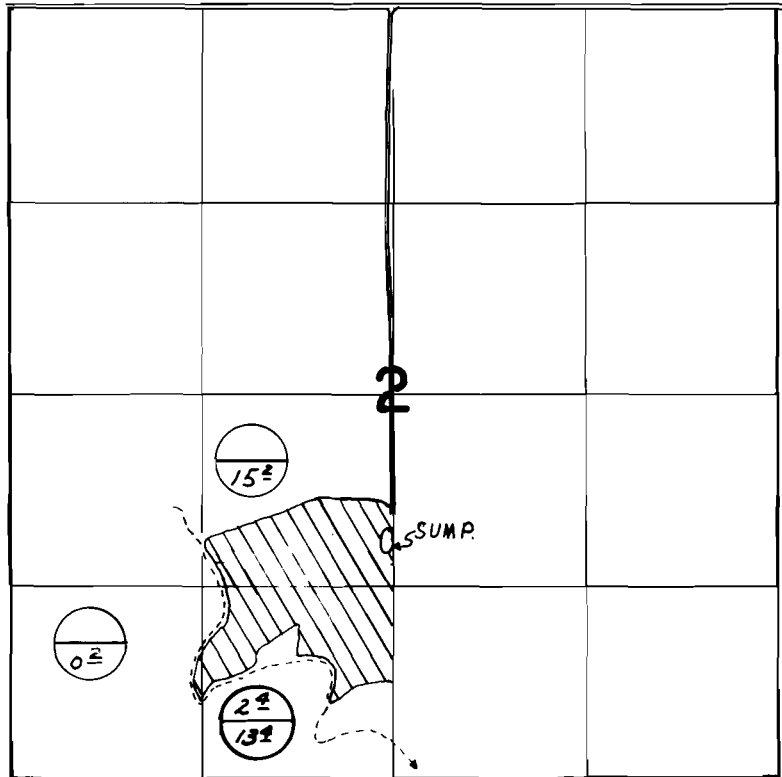

SUMP: 1650' N & 25' W FROM S 1/4 COR. SEC. 2



## FINAL PROOF SURVEY UNDER

Application No. G-5049 Permit No. G-4759  
IN NAME OF

FRED V. SPENCE, JR.

Surveyed JUNE 23, 1976, by G.R. KING