


# T. 8 S. R. 39 E. W. M.

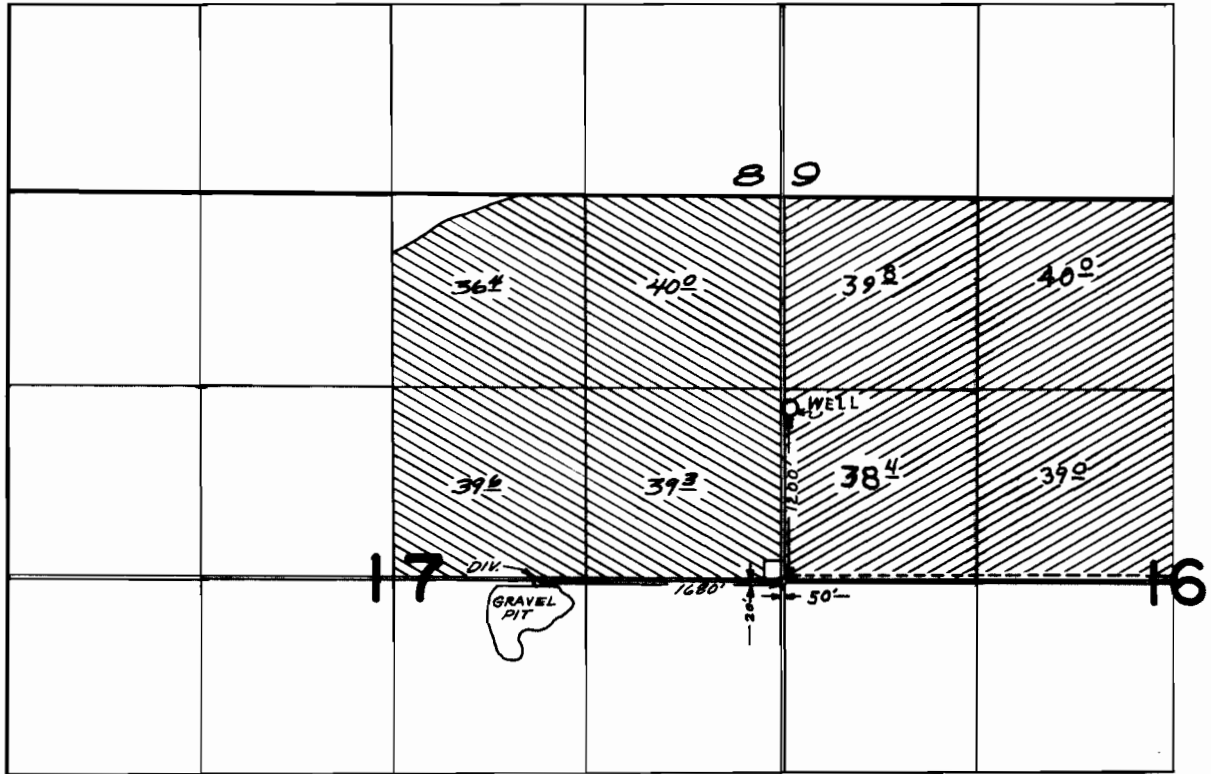

## FINAL PROOF SURVEY UNDER

G-6100

G-5780

Application No. G 5557 Permit No. G 4961

IN NAME OF

JIM & DAVE BLATCHFORD

Surveyed OCT 30 1974, by L.M. TOLL  
JUNE 24 76 C.R. KING

