

20 21
29 28

T.7S., R.39 E., W.M.

1/4 Cor. Stone


POWDER RIVER

HWY. U.S. 30

Ditch

S. 23° 37' W., 3268 (Stadia)

RADIUM SPRINGS PROPERTY

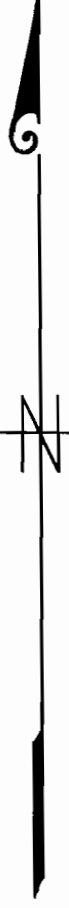

Well

32⁰

32⁰

34¹

34¹

28

26⁰

35⁰

Sand Creek

I, James D. Hanley, of Baker, Oregon, do hereby certify that this map was made from notes taken during an actual survey made by me on April 21, 1953, that the well shown on this map is S. 23° 37' W., 3268 feet from the 1/4 corner common to Secs. 21 and 28, T.7S., R.39E., W.M.

James D. Hanley

MAP TO ACCOMPANY APPLICATION TO APPROPRIATE WATER FOR IRRIGATION

SCALE 1" = 400'

Application No. U-681
Permit No. U-

