


T.12S., R.5W. W.M.

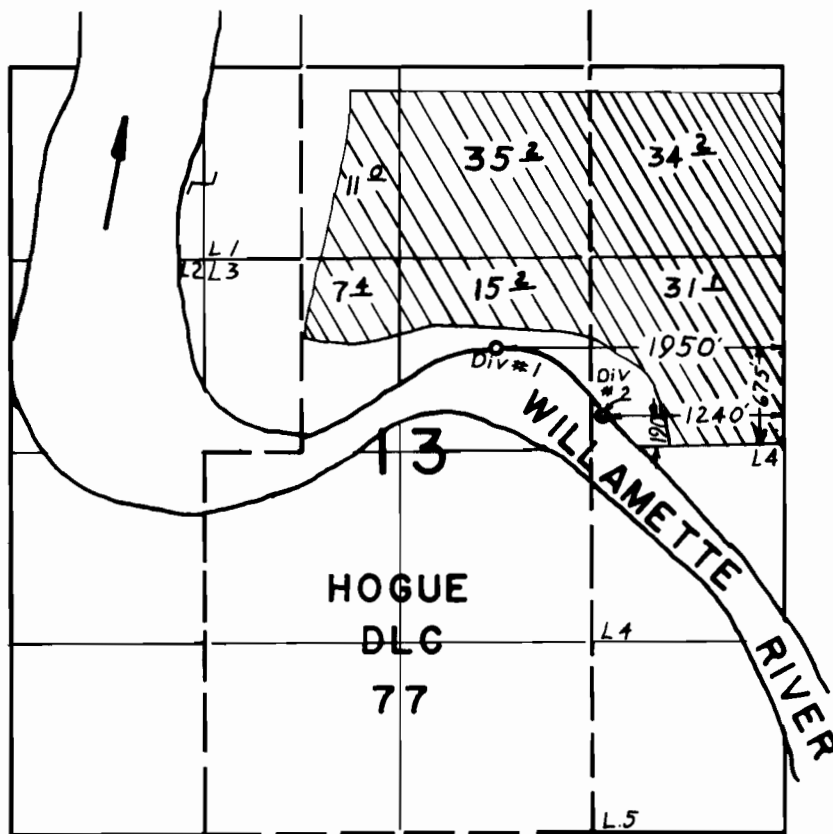

FINAL PROOF SURVEY
UNDER

Application No. 48029 Permit No. 35789
IN NAME OF

WAYNE & EUNICE ENDICOTT

Surveyed OCT. 4 1976, by G.R. KING