


T.10S.,R.6W.,W.M.

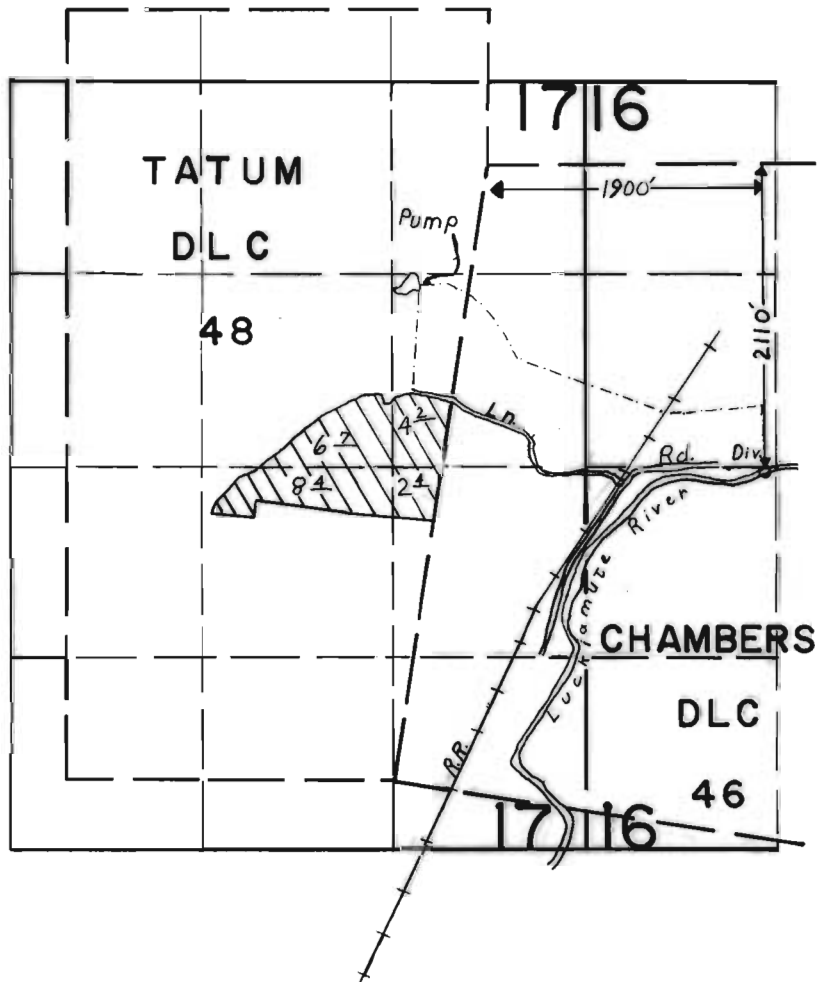

FINAL PROOF SURVEY
UNDER

Application No. 48653 Permit No. 36489
IN NAME OF

JACK E. MAHANA

Surveyed MAR. 29 1976 by C. R. KING