


T.5 S. R.1 E. W.M.

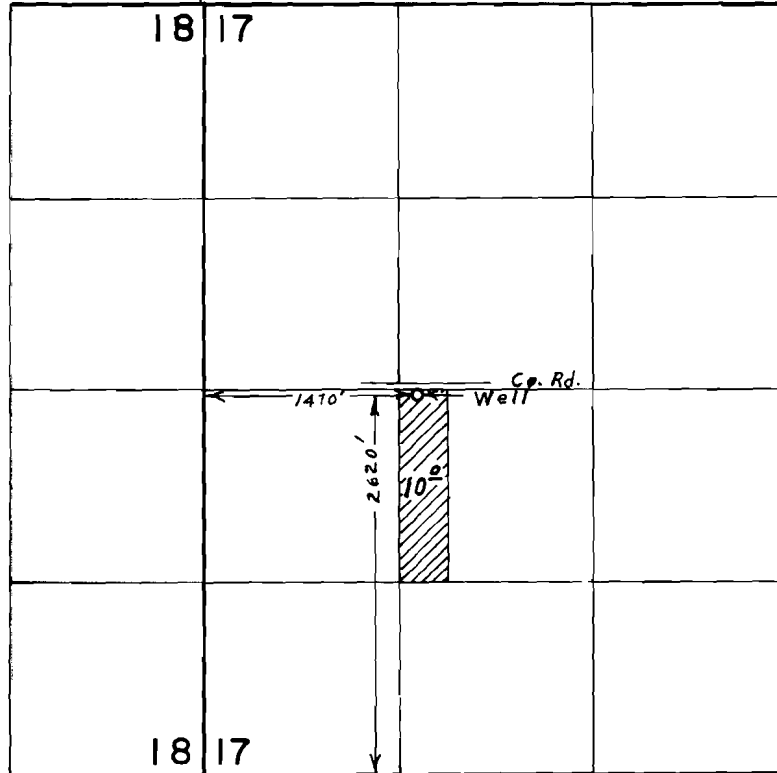

FINAL PROOF SURVEY
UNDER

Application No. G-5237 Permit No. G-5094
IN NAME OF

JEWEL S. GERMANY

Surveyed May 18, 1976, by L. E. Gould