


T. 5 S. R. 1 E. W. M.

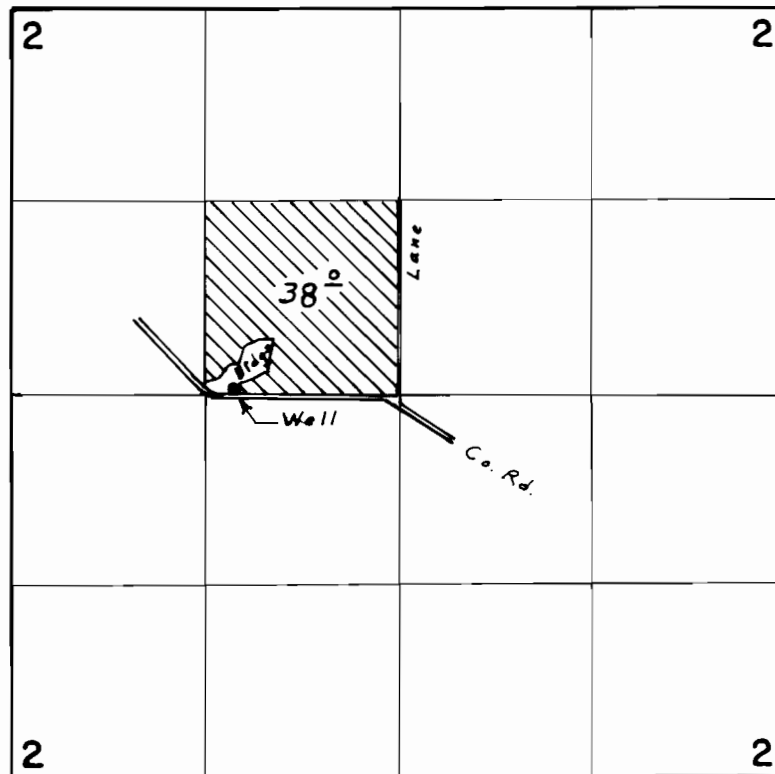

Well located; 40' N. & 120' W. from Center Sec. 2

FINAL PROOF SURVEY
UNDER

Application No. G-6083 Permit No. G-5769
IN NAME OF

Russell S. Lunning

Surveyed March 30, 1976, by L. E. Gould