


T.3 S. R.1 W. W.M.

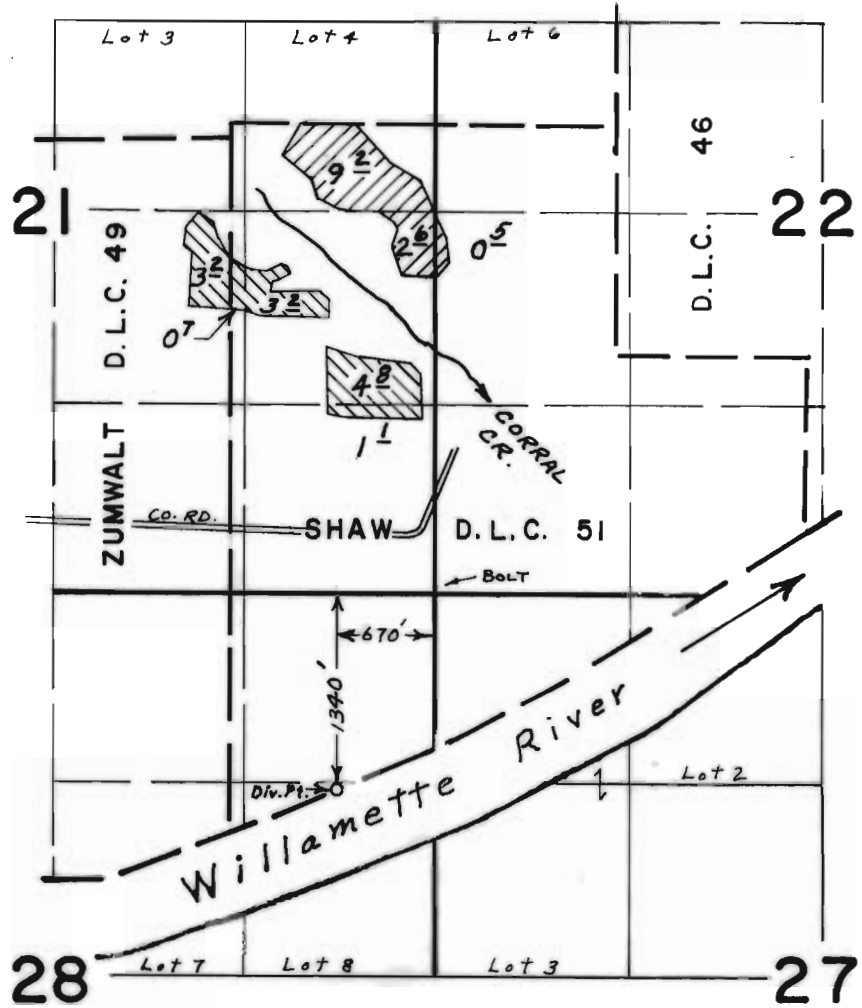

FINAL PROOF SURVEY UNDER

Application No. 51232 49879 Permit No. 38700 36336
 IN NAME OF

RICHARD A. & PATRICIA PEDERSEN

Surveyed July 8, 1976, by L. E. Gould