


T.4N.,R.10W.,W.M.

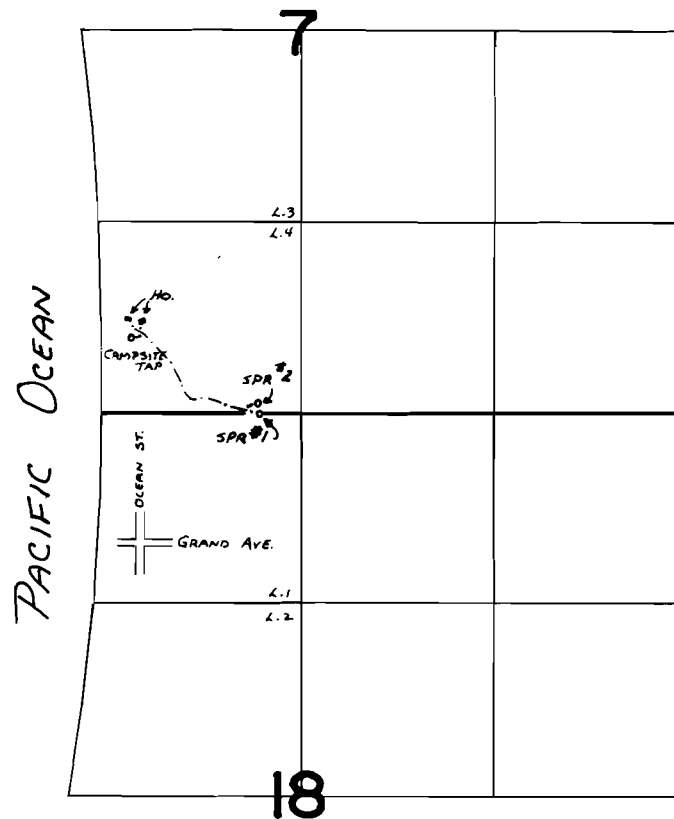

SPRING #1 - 270' W
SPRING #2 - 70' N AND 290' W } BOTH FROM S 1/4 COR SEC 7

FINAL PROOF SURVEY
UNDER

Application No. 46404 Permit No. 34652
IN NAME OF

Leslie L. Lucas

Surveyed SEPT. 23 1975, by L. E. Gault