


T.6 N. R.3 W. W.M.

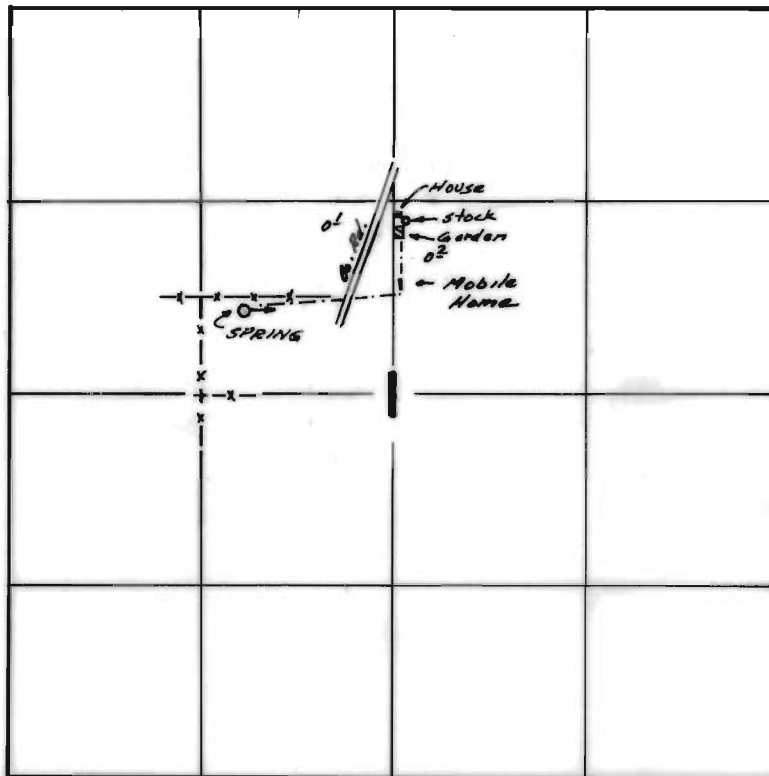

SPRING LOC. - 560' N + 300' E FROM SW COR. SE 1/4 NW 1/4 Sec. 1

FINAL PROOF SURVEY
UNDER

Application No. 49792. Permit No. 37460.
IN NAME OF
ESTATE OF
ROGER T. PATCHING

Surveyed Aug. 12. 1977. by S.C. BROWN