


T.25S.R.IIW.W.M.

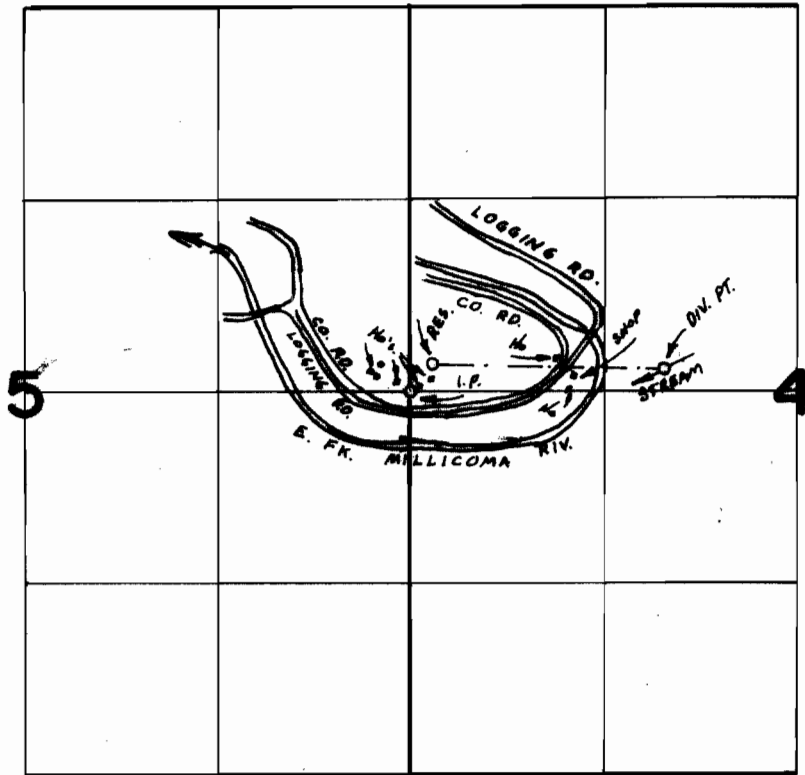

DIV. PT. LOC. 150' N. & 1740' E. FROM E. 1/4 COR
SEC. 5

FINAL PROOF SURVEY
UNDER

Application No. 46695 Permit No. 34666
IN NAME OF

JOHN W. KRUSE

Surveyed JUL 30 1974, by L.H. NUNN