


T.28S., R.13W., W.M.

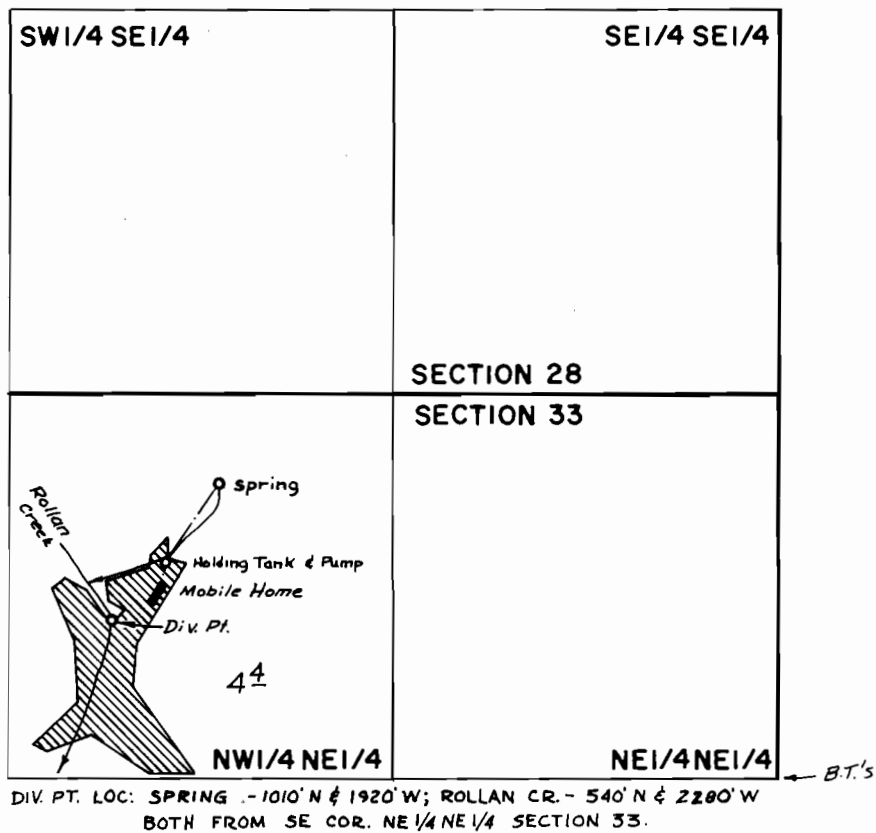

Scale: 1" = 660'

FINAL PROOF SURVEY
UNDER

Application No. 47488 Permit No. 35568
IN NAME OF

ARLIE L. AMOS

Surveyed July 20, 1976, by D. Norby